
Form 51 5M 8-24 16567

Greenwood

Map No. Kansas Sec. 22 Twp. 22 R. 10 W

Well No. 5 South Farm

Tidal Company

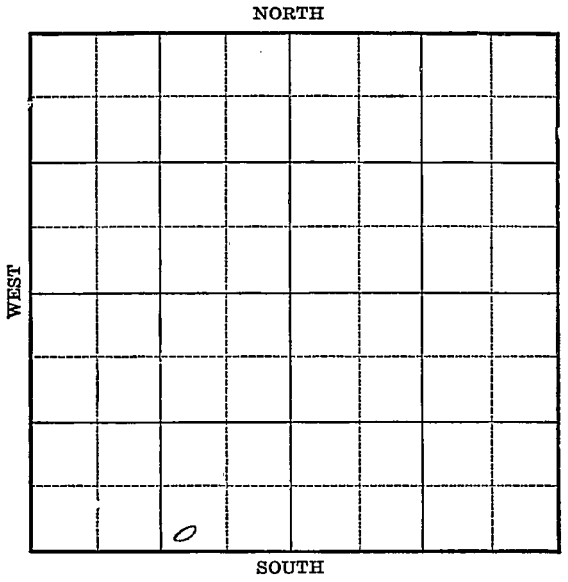

Location

Drilling Remarks

Rig Up

Drilling Remarks

RECORD

Cased in. ft.

Sand

Gas

Oil

Total Depth

PRODUCTION

1st 24 hrs. Nat.

1st. 24 hrs. after shot

Gas cu. ft.

Dry Hole


Abandoned

Form 252A 5M 8-24 16529 Greenwood Co

Map No. Kans Sec. 22 Twp. 22 R 11

Well No. 5 South Farm

Tidal Company

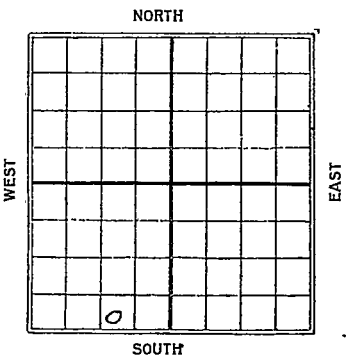

____ Ft. from N. Line

330 Ft. from S. Line

990 Ft. from E. Line

____ Ft. from W. Line

Date 1925	REPORT
2/8	Rig up
3/30	1949–63 Shot 60 qts
	25 Bbls

Form 26—1M Bks.—3-23—11959. Greenwood Co

Map No. 24 KANSAS Sec. 22 Twp. 22 R. 11

Well No. 5 South

T. Ideal Company

Contractor

FIRST REPORT


Ft. from N. Line

330 Ft. from S. Line

990 Ft. from E. Line

Ft. from W. Line

SECTION PLAT

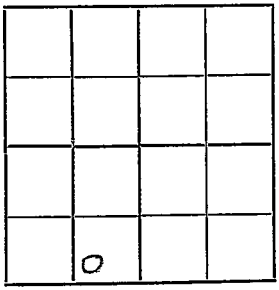

Location

Rig up

Drilling and Remarks:

RECORD

Cased in., ft.

Sand

Gas

Oil

Total Depth

PRODUCTION

1st 24 hrs. Nat.

1st 24 hrs. after shot

Gas Cu. Ft.

Dry Hole

Abandoned

Date

2/8 1925

M. A. BENEAR Scout

Form 26—1M Bks.—3-23—11959.

Map No. 21 KANSAS Sec. 22 Twp. 22 R. 11


Well No. 5 Smith

Tidal Company

Contractor

COMPLETED

SECTION PLAT

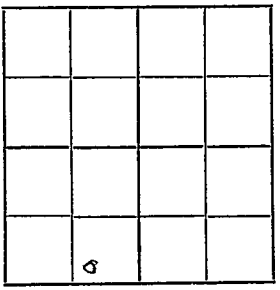

_____Ft. from N. Line

330 Ft. from S. Line

990 Ft. from E. Line

_____Ft. from W. Line

Location _____

Rig up _____

Drilling and Remarks:

shot 60 qts.

RECORD

Cased _____ in., _____ ft.

Sand _____

Gas _____

Oil 1949-63

Total Depth 1963

PRODUCTION

1st 24 hrs. Nat. _____

1st 24 hrs. after shot 35

Gas _____ Cu. Ft.

Dry Hole _____

Abandoned _____

Date

3/20 1926

M. A. BENEAR

_____ Scout