


Map No. **KANSAS** Sec 23 Twp. 22 R. 12

Well No. 4 Frankhouser Farm  
Theta Oil Co Company

NORTH

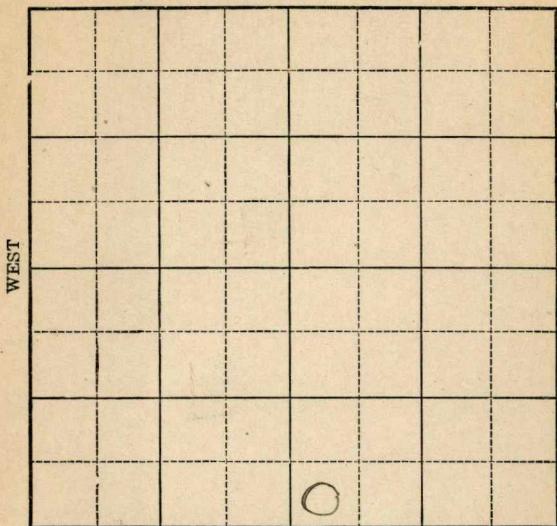

SOUTH

Location \_\_\_\_\_  
Drilling Remarks \_\_\_\_\_

Rig Up \_\_\_\_\_  
Drilling Remarks \_\_\_\_\_

\_\_\_\_\_

\_\_\_\_\_

**RECORD**

**PRODUCTION**

Cased \_\_\_\_\_ in. \_\_\_\_\_ ft.

Sand \_\_\_\_\_

Gas \_\_\_\_\_

Oil \_\_\_\_\_

Total Depth \_\_\_\_\_

1st 24 hrs. Nat. \_\_\_\_\_

1st 24 hrs. after shot \_\_\_\_\_

Gas \_\_\_\_\_ cu. ft.

Dry Hole \_\_\_\_\_

Abandoned \_\_\_\_\_



*Sherwood*

E

21 **KANSAS** Map No. Sec. 23 Twp. 22 R. 12

Well No. 4 *Janthouse*  
*Metz Oil Co* Company

Contractor

**FIRST REPORTS**

**SECTION PLAT**

----- Ft. from N. Line  
*330*  
----- Ft. from S. Line  
----- Ft. from E. Line  
*330*  
----- Ft. from W. Line

		o	

Location *Log*  
Rig up  
Drilling and Remarks:

**RECORD**

Cased \_\_\_\_\_ in., \_\_\_\_\_ ft.  
Sand \_\_\_\_\_  
Gas \_\_\_\_\_  
Oil \_\_\_\_\_  
Total Depth \_\_\_\_\_

**PRODUCTION**

1st 24 hrs. Nat. \_\_\_\_\_  
1st 24 hrs. after shot \_\_\_\_\_  
Gas \_\_\_\_\_ Cu. Ft.  
Dry Hole \_\_\_\_\_  
Abandoned \_\_\_\_\_

Date

**JAN 11 1928**

**CHAS. L. SHERWOOD**

*Sherwood*

Map No. **31 KANSAS** Sec. *23* Twp. *22* R. *12*

Well No. *4* *Zankhauser*

*Zeta Oil Co* Company

Contractor

**COMPLETED**

**SECTION PLAT**

----- Ft. from N. Line

*330*

----- Ft. from S. Line

----- Ft. from E. Line

*330*

----- Ft. from W. Line

		<i>0</i>	

Location -----

Rig up -----

Drilling and Remarks:

*7007 100 lbs.*

**RECORD**

Cased \_\_\_\_\_ in., \_\_\_\_\_ ft.

Sand *1669-1715*

Gas -----

Oil -----

Total Depth *1719*

**PRODUCTION**

1st 24 hrs. Nat. -----

1st 24 hrs. after shot -----

Gas ----- Cu. Ft.

Dry Hole -----

Abandoned -----

Date

**FEB 15 1928**

**CHAS. L. SHERWOOD**

192

Scout