

Greenwood

Map No. **KANSAS** Sec. *23* Twp. *22* R. *12^E*

Well No. *9-Funkhouser* Farm
Theta Oil Company


330 Ft. from N. Line

_____ Ft. from S. Line

_____ Ft. from E. Line

330 Ft. from W. Line

1930

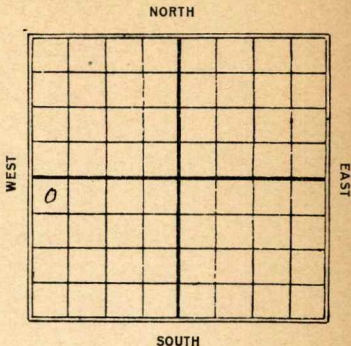

Date

REPORT

6/11

Loc

6/18

mach.

6/25

blg. 350'

7/2

" 1150'

7/19

Oil 1688-1702'

TD 1702

shot 25 gc

*25 bal oil
Comp.*

Greenwood

21 **KANSAS** Map No. Sec. 23 Twp. 22 R. 12^E

Well No. 9 Jankhuser
 Theta Oil Co Company

Contractor

FIRST REPORTS

SECTION PLAT

330 Ft. from N. Line
 _____ Ft. from S. Line
 _____ Ft. from E. Line
 330 Ft. from W. Line

0			

Location

Rig up _____

Drilling and Remarks:

RECORD

Cased _____ in., _____ ft.
 Sand _____
 Gas _____
 Oil _____
 Total Depth _____

PRODUCTION

1st 24 hrs. Nat. _____
 1st 24 hrs. after shot _____
 Gas _____ Cu. Ft.
 Dry Hole _____
 Abandoned _____

Date

JUN 11 1930

19

CHAS. L. SHERWOOD

Scout

Greenwood

Map No. **KANSAS** Sec. *23* Twp. *22* R. *12*

Well No. *9* *Fauphouser*

Theta Oil Co Company

Contractor

COMPLETE

SECTION PLAT

330 Ft. from N. Line
 _____ Ft. from S. Line
 _____ Ft. from E. Line
330 Ft. from W. Line

<i>0</i>			

Location _____

Rig up _____

Drilling and Remarks:

25/25 Abs

RECORD

Cased _____ in., _____ ft.

Sand *1688-1702*

Gas _____

Oil _____

Total Depth *1702*

PRODUCTION

1st 24 hrs. Nat. _____

1st 24 hrs. after shot _____

Gas _____ Cu. Ft.

Dry Hole _____

Abandoned _____

Date

JUL 9 1930

CHAS. L. SHERWOOD

19

Scout