

Map No. _____ Sec. 23 Twp. 22 R. 12


Well No. 6-Fankhouser Farm
Theta Oil Company

_____ Ft. from N. Line

830 Ft. from S. Line

330 Ft. from E. Line

_____ Ft. from W. Line

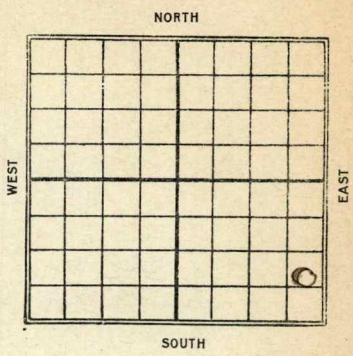

1928

Date	REPORT
------	--------

<u>1/26</u>	<u>R.O.G.</u>
<u>2/2</u>	<u>Bldg rig</u>
<u>2/9</u>	<u>Rigging up</u>
<u>2/16</u>	<u>Drlg - 400-</u>
<u>2/23</u>	<u>" 930</u>
<u>3/1</u>	<u>" 1647-</u>
<u>3/8</u>	<u>1679-1711 T.D. 1718</u>
	<u>140/125 bbls</u>

Sherwood

Map No. 21 **KANSAS** Sec. 23 Twp. 22 R. 12

Well No. 6 *Zankhausen*
Zhety Oil Co Company

Contractor

FIRST REPORTS

SECTION PLAT

----- Ft. from N. Line
830 Ft. from S. Line
330 Ft. from E. Line
----- Ft. from W. Line

			o

Location -----
Rig up -----
Drilling and Remarks:

ROG

RECORD

Cased ----- in., ----- ft.
Sand -----
Gas -----
Oil -----
Total Depth -----

PRODUCTION

1st 24 hrs. Nat. -----
1st 24 hrs. after shot -----
Gas ----- Cu. Ft.
Dry Hole -----
Abandoned -----

Date

JAN 26 1928

CHAS. L. SHERWOOD

192

Scout

Sherwood

21 **KANSAS** Sec. 23 Twp. 22 R. 12

Well No. 6 Joneshouser
Theta Oil Co Company

Contractor

COMPLETED

SECTION PLAT

----- Ft. from N. Line
830 Ft. from S. Line
330 Ft. from E. Line
----- Ft. from W. Line

Location -----
Rig up -----
Drilling and Remarks:

140/125 lbs.

RECORD

Cased ----- in., ----- ft.
Sand *1679-1711*
Gas -----
Oil -----
Total Depth *1718*

PRODUCTION

1st 24 hrs. Nat. -----
1st 24 hrs. after shot -----
Gas ----- Cu. Ft.
Dry Hole -----
Abandoned -----

Date
MAR 8 1928

CHAS. L. SHERWOOD