

Greenwood


Form 51-5M-2-29-34703

Map No. **KANSAS** Sec. 23 Twp. 22 R. 12^E

Well No. 10 - Fankhauser Farm

Theta Oil Company

NORTH

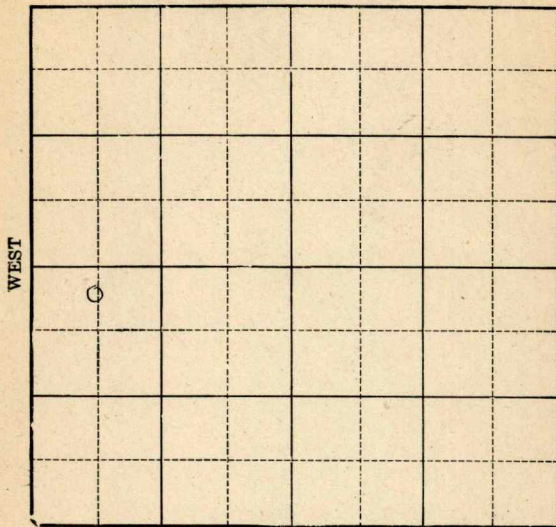

Location _____

Drilling Remarks _____

Rig Up _____

Drilling Remarks _____

RECORD

Cased _____ in. _____ ft.

Sand _____

Gas _____

Oil _____

Total Depth _____

PRODUCTION

1st 24 hrs. Nat. _____

1st 24 hrs. after shot _____

Gas _____ cu. ft. _____

Dry Hole _____

Abandoned _____

Map No. **KANSAS** Sec. 23 Twp. 22 R. 12^E

Well No. 10-Fanhausen Farm
Theta Oil Company


250 Ft. from N. Line

_____ Ft. from S. Line

_____ Ft. from E. Line

650 Ft. from W. Line

1931

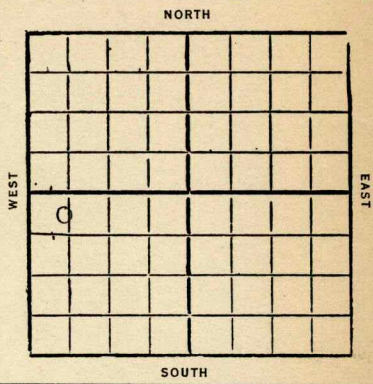

Date	REPORT
12/2	Loc
12/19	Moving in mach
12/16	regrind up
12/22	F
12/30	Drg 350'
1932	Drg 650'
1/7	Sand 1683-98
1/13	Shot 40 qt
	Olg out
1/19	Sand 1683-98
	TD. 1698
	Shot 40 qt
	35 bbl oil
	Comp.

Greenwood

Map No. **KANSAS** Sec. *23* Twp. *22* R. *12* ^E

Well No. *10* *Jankhauer*

Shela Oil Co Company

Contractor

FIRST REPORTS

250 Ft. from N. Line

..... Ft. from S. Line

..... Ft. from E. Line

650 Ft. from W. Line

SECTION PLAT

<i>o</i>			

Location

Rig up

Drilling and Remarks:

RECORD

Cased.....in.,ft.

Sand.....

Gas.....

Oil.....

Total Depth.....

PRODUCTION

1st 24 hrs. Nat.....

1st 24 hrs. after shot.....

Gas.....Cu. Ft.

Dry Hole.....

Abandoned.....

Date

DEC 2 1931

CHAS. L. SHERWOOD

Greenwood

Map No. ^{KANSAS} 2/ Sec. 23 Twp. 22 R. 12^E

Well No. 10 Frankhouser

Theta Oil Co Company

Contractor

COMPLETED

SECTION PLAT

750 Ft. from N. Line

Ft. from S. Line

Ft. from E. Line

650 Ft. from W. Line

o			

Location

Rig up

Drilling and Remarks:

40/35 Bls.

RECORD

Cased in., ft.

Sand 1683-1698

Gas

Oil

Total Depth 1698

PRODUCTION

1st 24 hrs. Nat.

1st 24 hrs. after shot

Gas Cu. Ft.

Dry Hole

Abandoned

Date

JAN 20 1932

CHAS. L. SHERWOOD

192 Scout