

KANSAS


Greenwood county ✓

FORM 51 5M 6-46 PETROL

Section 23 Township 22 Range 12-E

Well No. #16, Frankhouser (Frankhouser)

Company Jackman and Jackman

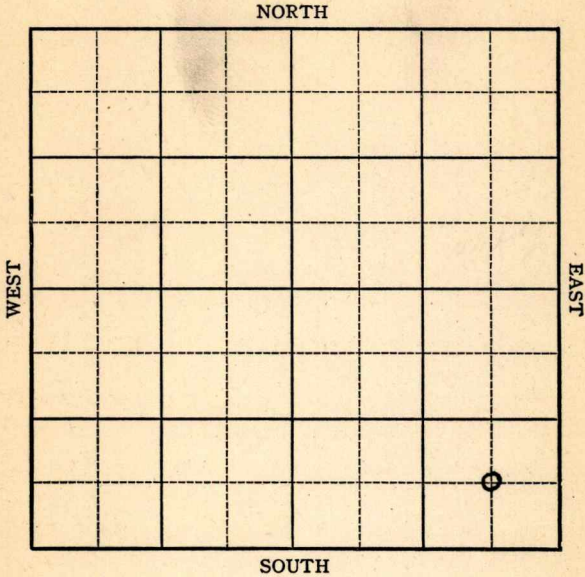

Sec. 23 Twp. 22 R. 12E

Well No. #16 Fankhouser Farm

Jackman & Jackman Company


Miscellaneous

_____ Ft. from N. Line

660 Ft. from S. Line

660 Ft. from E. Line

_____ Ft. from W. Line

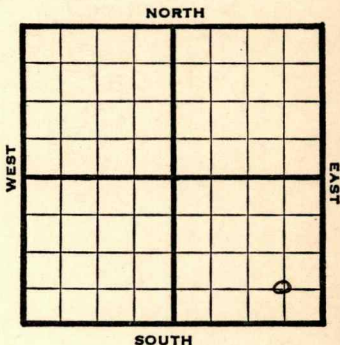

C SE SE

REPORT

1946

| | |
|-------|---|
| 9/11 | Location |
| 9/18 | RUR |
| 9/24 | 10" @ 25' Drlg 1400' |
| 10/1 | Bart 1655 TD 7" @ 1645 RUST |
| 10/8 | 1728 SDO |
| 10/15 | SD |
| 10/22 | TD 1732' 100 qts 1680-1700, 100' oil |
| 10/29 | " " " |
| 11/6 | Bart 1655' 7" @ 1645' TD 1732' |

ABANDONED

Form 26 200 Bks. 10-46 Petrol
Kansas

Map No. 21 Sec. 23 Twp. 22 R. 12E

Well No. 16 Fankhouser

Jackman & Jackman Company

ABANDONED

Contractor

C SE SE

SECTION PLAT

 Ft. from N. Line

660 Ft. from S. Line

660 Ft. from E. Line

 Ft. from W. Line

| | | | |
|--|--|--|---|
| | | | |
| | | | |
| | | | |
| | | | o |

Greenwood County

Location

Rig up

Drilling and Remarks:

*Bar 4/1655
7" C 1645*

RECORD

Cased in., ft.

Sand

Gas

Oil

Total Depth 1232

PRODUCTION

1st 24 hrs. Nat.

1st 24 hrs. after shot

Gas Cu. Ft.

Dry Hole

Abandoned

Date

NOV 6 1946 19

S. J. LEWIS

Scout

Kansas Pool Name Miscellaneous

Map No. 21 Sec. 23 Twp. 22 R. 12E

Well No. 16 Fankhouser

Jackman & Jackman Company

FIRST REPORT Contractor

C SE SE

SECTION PLAT

_____ Ft. from N. Line

660 Ft. from S. Line

660 Ft. from E. Line

_____ Ft. from W. Line

| | | | |
|--|--|--|---|
| | | | |
| | | | |
| | | | |
| | | | o |

Greenwood County

Location X

Rig up _____

Drilling and Remarks:

RECORD

Cased _____ in., _____ ft.

Sand _____

Gas _____

Oil _____

Total Depth _____

PRODUCTION

1st 24 hrs. Nat. _____

1st 24 hrs. after shot _____

Gas _____ Cu. Ft.

Dry Hole _____

Abandoned _____

Date

9-11 1946

S. J. LEWIS Scout