



Map No. *Kansas* Sec. *23* Twp. *22* R. *12*

Well No. *1-Schwab* Farm


*Prairie O. G.* Company

..... Ft. from N. Line

*330* Ft. from S. Line

..... Ft. from E. Line

*990* Ft. from W. Line

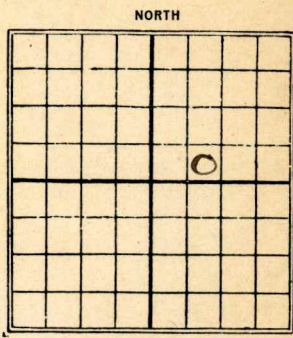

*1927*

Date	REPORT
------	--------

*11/23* Location

*11/30* Rig

*12/7* Spudding *200'*

*12/14* " *270'*

*12/21* Drly *750.*

*12/28* " *1425*

*1928*

*1/5* Sdy shale *1625-84* Sand *1684-*

*1702* - small show - Shale *1702-06*

*S.D. for orders-*

*1/11*

*1/18* Sdy Shale *1625-1684*

Sand *1684-1702*

small show

*S. & a. 1765'*

Sherwood

21 **KANSAS** Sec. 23 Twp. 22 R. 12

Well No. 1 Schwab

Prarie Oil Co Company

Contractor

**COMPLETED**

**SECTION PLAT**

----- Ft. from N. Line

330 Ft. from S. Line

----- Ft. from E. Line

990 Ft. from W. Line

		0	

**ABANDONED**

Location -----

Rig up -----

Drilling and Remarks:

Arg shale 1625-1684

hard 1684-1702  
mass show

DQH 1765

**RECORD**

Cased ----- in., ----- ft.

Sand -----

Gas -----

Oil -----

Total Depth 1765

**PRODUCTION**

1st 24 hrs. Nat. -----

1st 24 hrs. after shot -----

Gas ----- Cu. Ft.

Dry Hole ✓ -----

Abandoned ✓ -----

Date

JAN 13 1928

**CHAS. L. SHERWOOD**

192

Scout

*Sherwood* <sup>E</sup>

21 **KANSAS**

Map No. \_\_\_\_\_ Sec. *23* Twp. *22* R. *12*

Well No. *1* *Schwab*

*Prairie Oil & Gas* Company

Contractor \_\_\_\_\_

**FIRST REPORTS**


**SECTION PLAT**

\_\_\_\_\_ Ft. from N. Line

*330* Ft. from S. Line

\_\_\_\_\_ Ft. from E. Line

*990* Ft. from W. Line

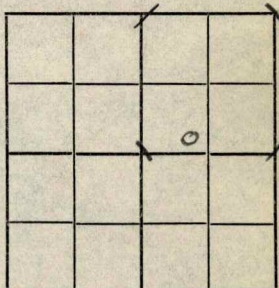

Location  \_\_\_\_\_

Rig up \_\_\_\_\_

Drilling and Remarks:

**RECORD**

Cased \_\_\_\_\_ in., \_\_\_\_\_ ft.

Sand \_\_\_\_\_

Gas \_\_\_\_\_

Oil \_\_\_\_\_

Total Depth \_\_\_\_\_

**PRODUCTION**

1st 24 hrs. Nat. \_\_\_\_\_

1st 24 hrs. after shot \_\_\_\_\_

Gas \_\_\_\_\_ Cu. Ft.

Dry Hole \_\_\_\_\_

Abandoned \_\_\_\_\_

Date

**NOV 23 1927**

**CHAS. L. SHERWOOD**

192

Scout