

Map No. 75 Sec. 23 Twp. 22 R. 10

Well No. 1' Clepton Farm


Syndicate Oil Company

_____ Ft. from N. Line

200 Ft. from S. Line

200 Ft. from E. Line

_____ Ft. from W. Line

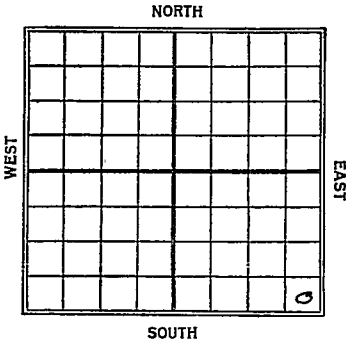

Date 1923

REPORT

11/24 Timbers

1924

2/1 Ad Ed 9-2270'

Map No. KANSAS 21 Sec. 23 Twp. 22 R. 10

Well No. 1 C Lester

Synthetic oil Company

Contractor

FIRST REPORT

SECTION PLAT

_____ Ft. from N. Line

200 Ft. from S. Line

200 Ft. from E. Line

_____ Ft. from W. Line

			0

Location _____

Rig up _____

Drilling and Remarks:

Timber

RECORD

Cased _____ in., _____ ft.

Sand _____

Gas _____

Oil _____

Total Depth _____

PRODUCTION

1st 24 hrs. Nat. _____

1st 24 hrs. after shot _____

Gas _____ Cu. Ft.

Dry Hole _____

Abandoned _____

Date

NOV 24 1923

M. A. BENEAR

192

Scout

Map No. *21* Sec. *23* Twp. *22* R. *10*

Well No. *#1 C. Lipton*

Synchrinate Company

Contractor

ABANDONED

SECTION PLAT

SPECIAL			

_____ Ft. from N. Line

200' Ft. from S. Line

200' Ft. from E. Line

_____ Ft. from W. Line

Location _____

Rig up _____

Drilling and Remarks:
2049
2270'

RECORD

Cased _____ in., _____ ft.

Sand _____

Gas _____

Oil _____

Total Depth _____

PRODUCTION

1st 24 hrs. Nat. _____

1st 24 hrs. after shot _____

Gas _____ Cu. Ft.

Dry Hole _____

Abandoned _____

Date
FEB

1924

BENEAR

192

Scout

(Over)