


Map No. _____ Sec. 23 Twp. 22 R. 11
Well No. 2 Sheet _____ Farm _____
Roxana & Schwartz Company

NORTH

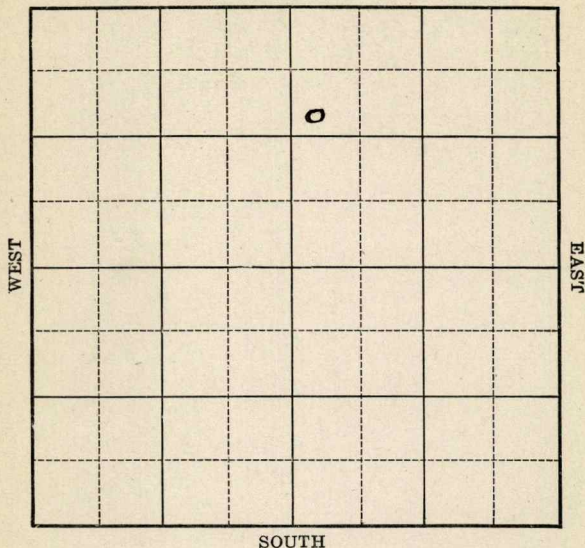

Location

Drilling Remarks

Rig Up_____

Drilling Remarks

RECORD

Cased _____ in. _____ ft.

Sand

Gas

Oil

Total Depth.....

PRODUCTION

1st 24 hrs. Nat. -----

1st 24 hrs. after shot-----

Gas _____ cu. ft.

Dry Hole

Abandoned

Greenwood

Map No. _____ Sec. 23 Twp. 22 R. 11Well No. 3 - Sheets FarmRovana & Schwartz Company

NORTH


990 Ft. from N. Line

_____ Ft. from S. Line

_____ Ft. from E. Line

330 Ft. from W. Line

WEST

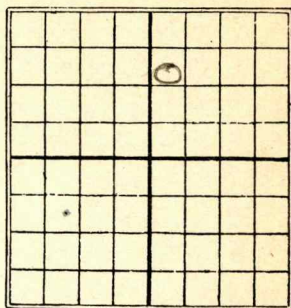

SOUTH

1927

Date

REPORT

8/1 Drilg 600'
9/7 " 1050
9/28 1872-1894
T.D. 1895
Sdy shale 1856-72
100/100 bbl

Map No. 24 **KANSAS** Sec. 23 Twp. 22 R. 11

Well No. 3 Sheets

Noxon & Schwartz Company

Contractor

COMPLETED

SECTION PLAT

		0	

990 Ft. from N. Line

----- Ft. from S. Line

----- Ft. from E. Line

330 Ft. from W. Line

Location -----

Rig up -----

Drilling and Remarks:

Sky Shale 1856-72

100/100 lbs.

RECORD

Cased ----- in., ----- ft.

Sand 1872-1894

Gas -----

Oil -----

Total Depth 1895

PRODUCTION

1st 24 hrs. Nat. -----

1st 24 hrs. after shot -----

Gas ----- Cu. Ft.

Dry Hole -----

Abandoned -----

Date

SEP 28 1927

192

CHAS. L. SHERWOOD

Scout

K21 KANSAS

Map No. _____ Sec. 23 Twp. 22 R. 11

Well No. 3 sheets

Loxang & Schwartz Company

Contractor

FIRST REPORTS

990 Ft. from N. Line

Ft. from S. Line

Ft. from E. Line

330 Ft. from W. Line

SECTION PLAT

		0	

Location _____

Rig up _____

Drilling and Remarks:

dy 600'

RECORD

Cased _____ in., _____ ft.

Sand _____

Gas _____

Oil _____

Total Depth _____

PRODUCTION

1st 24 hrs. Nat. _____

1st 24 hrs. after shot _____

Gas _____ Cu. Ft.

Dry Hole _____

Abandoned _____

Date

SEP 1 - 1927 CHAS. L. SHERWOOD

192

Scout