


Map No. Taus Sec. 23 Twp. 22 R. 11
 Well No. 1-4 Sheets Frankhouse Farm
Schwartz et al Company

330 Ft. from N. Line
 _____ Ft. from S. Line
 _____ Ft. from E. Line
990 Ft. from W. Line
1926

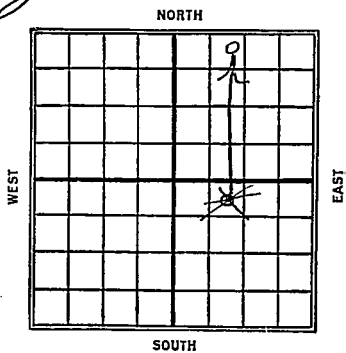

Date	REPORT
10/27	location
11/11	same
11/17	same
11/23	same Rig
12/8	S.D. 450
12/15	Drlg 800'
12/22	" 1100
12/30	" 1225
1927	1/6 Broken sand 1840-48 sand 1848' 1st oil 1855-1888 T.D. 1891' filled up 300' in 5 hours, will shoot.
1/12	Sand 1848-1888 T.D. 1891 1st oil 1855 130 gts 250 bbls

Greenwood

21 KANSAS, 23 Sec. Twp. 22 R. 11

Well No. 1 Frankhouser

Schwartz et al Company

Contractor

FIRST REPORTS

SECTION PLAT

220 Ft. from N. Line

Ft. from S. Line

Ft. from E. Line

990 Ft. from W. Line

		○	

Location ✓

Rig up

Drilling and Remarks:

RECORD

Cased _____ in., _____ ft.

Sand _____

Gas _____

Oil _____

Total Depth _____

PRODUCTION

1st 24 hrs. Nat. _____

1st 24 hrs. after shot _____

Gas _____ Cu. Ft.

Dry Hole _____

Abandoned _____

Date

OCT 27 1926

CHAS I SHEPWOOD

192

Scout

Sherwood

Map No. 21 KANSAS Sec. 23 Twp. 22 R. 11

Well No. 1 *Sheets*

Schwartz & Roxburgh Company

Contractor

CORRECTION

330 Ft. from N. Line

_____ Ft. from S. Line

_____ Ft. from E. Line

990 Ft. from W. Line

SECTION PLAT

		o ↑	
		o	

Location _____

Rig up

Drilling and Remarks:

*chg loc to
shown*

RECORD

Cased _____ in., _____ ft.

Sand _____

Gas _____

Oil _____

Total Depth _____

PRODUCTION

1st 24 hrs. Nat. _____

1st 24 hrs. after shot _____

Gas _____ Cu. Ft.

Dry Hole _____

Abandoned _____

Date


NOV 23 1926

CHAS. L. SHERWOOD

Sherwood

21 KANSAS Map No. Sec. 23 Twp. 22 R. 11

Well No. 1 Sheets Farm Company
Schwartz & Roxburg

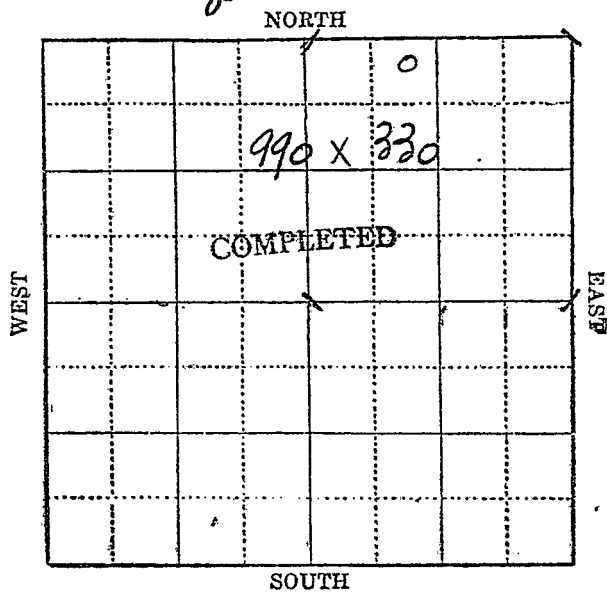

Location _____

Rig up _____

Drilling and Remarks:

Broken down 1840-48

1st oil 1855'

1300 250 lbs.

RECORD

Cased _____ in., _____ ft.

Sand *1848-1888*

Gas _____

Oil _____

Total Depth *1891' Sub*

PRODUCTION

1st 24 hrs. Nat. _____

1st 24 hrs. after shot _____

Gas _____ Cu. Ft.

Dry Hole _____

Abandoned _____

Date *JAN 12 1927*

CHAS. L. SHERWOOD