


Kansas

Map No. _____ Sec. 23 Twp. 22 R. 11

Well No. 12 - Subby _____ Farm
Empire G. & F. _____ Company

NORTH

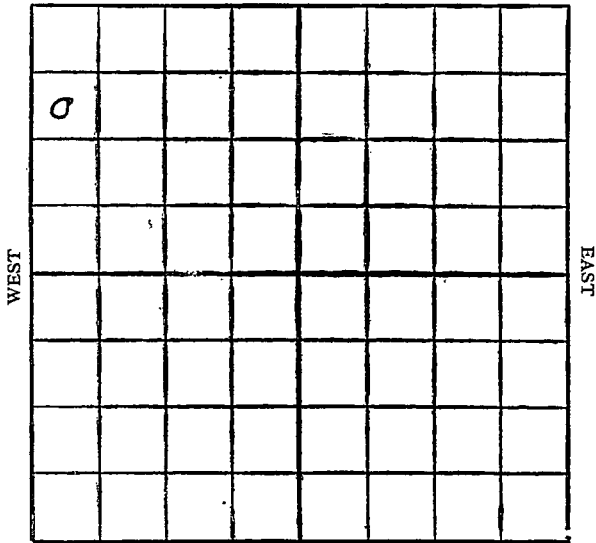

Location _____

Drilling Remarks _____

Rig Up _____

Drilling Remarks _____

RECORD

Cased _____ in. _____ ft.
Sand _____
Gas _____
Oil _____
Total Depth _____

PRODUCTION

1st 24 hrs. Nat. _____
1st 24 hrs. after shot _____
Gas _____ cu. ft.
Dry Hole _____
Abandoned _____

Kansas

Map No. Sec. 23 Twp. 22 R. 11

Well No. 12 - Duby Farm
Empire G. & F. Company


790 Ft. from N. Line

Ft. from S. Line

Ft. from E. Line

330 Ft. from W. Line

1927

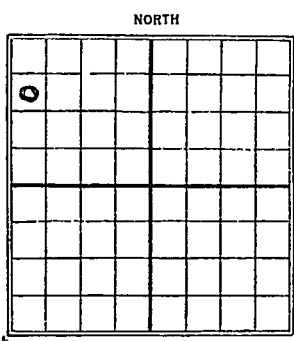

Date	REPORT
------	--------

2/10	R & G
------	-------

2/17	Bldg Rig
------	----------

4/24	Rig
------	-----

3/2	
-----	--

3/9	Drlg 350
-----	----------

3/16	" 1080
------	--------

3/24	Running 8"-1615
------	-----------------

3/30	Sand 1870-1905
------	----------------

90/180 bbls

F.A. 1906

Sherwood

21 KANSAS
 Map No. _____ Sec. *22* Twp. *22* R. *11*

Well No. *12* *Duhy*
Empire *52* *50* Company _____

Contractor _____

FIRST REPORTS

SECTION PLAT

990' _____ Ft. from N. Line
 _____ Ft. from S. Line
 _____ Ft. from E. Line
230 _____ Ft. from W. Line

<i>0</i>			

Location _____

Rig up _____

Drilling and Remarks:

104

RECORD

Cased _____ in., _____ ft.
 Sand _____
 Gas _____
 Oil _____
 Total Depth _____

PRODUCTION

1st 24 hrs. Nat. _____
 1st 24 hrs. after shot _____
 Gas _____ Cu. Ft.
 Dry Hole _____
 Abandoned _____

Date

FEB 10 1927

192

CHAS. L. SHERWOOD

Scout

Barnwood

21 KANSAS Sec. 22 Twp. 22 R. 11

Well No. 112 July

Empire Oil & Gas Co

Company

Contractor

COMPLETED

SECTION PLAT

990 Ft. from N. Line

_____ Ft. from S. Line

_____ Ft. from E. Line

330 Ft. from W. Line

0			

Location _____

Rig up _____

Drilling and Remarks:

RECORD

Cased _____ in., _____ ft.

Sand 1870-1905

Gas _____

Oil _____

Total Depth 1906

997 180 lbs

PRODUCTION

1st 24 hrs. Nat. _____

1st 24 hrs. after shot _____

Gas _____ Cu. Ft.

Dry Hole _____

Abandoned _____

Date

MAR 30 1927

CHAS. L. SHERWOOD

1927

Scout