

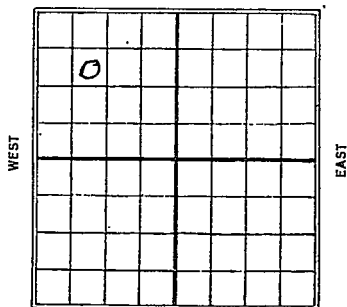
KANSASMap No. _____ Sec. 23 Twp. 22 R. 11Well No. 20 - Hurby Farm
Empire O. & R. Company

NORTH

990 Ft. from N. Line

_____ Ft. from S. Line

_____ Ft. from E. Line

990 Ft. from W. Line

SOUTH

1928

Date

REPORT

6/20 Hurby 1500'

6/28 O.S.D. 1600

7/5 1870-1894 T.D. 1897

60/45 bbls

Sherwood

21 KANSAS 23 22 11

MAP No. _____ SEC. _____ TWP. _____ R. _____

WELL No. *20* *Duker*

Empire Oil Co _____ COMPANY

_____ CONTRACTOR

FIRST REPORTS

990 _____ FT. FROM N. LINE

_____ FT. FROM S. LINE

_____ FT. FROM E. LINE

990 _____ FT. FROM W. LINE

SECTION PLAT

0			
	1		

LOCATION _____

RIG UP _____

DRILLING AND REMARKS:

By 1500

RECORD

CASED _____ IN. _____ FT.

SAND _____

GAS _____

OIL _____

TOTAL DEPTH _____

PRODUCTION

1ST 24 HRS. NAT. _____

1ST 24 HRS. AFTER SHOT _____

GAS _____ CU. FT.

DRY HOLE _____

ABANDONED _____

DATE

JUN 28 1928

CHAS. L. SHERWOOD

SCOUT

