


Greenwood

Map No. KANSAS Sec. 23 Twp. 22 R. 11E

Well No. 1 Frankenhausen Farm

Hall's Bros Company

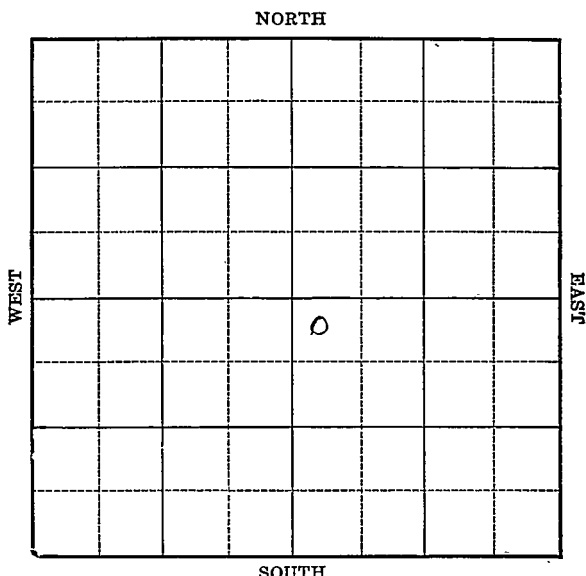

Location _____

Drilling Remarks _____

Rig Up _____

Drilling Remarks _____

RECORD

Cased _____ in. _____ ft.

Sand _____

Gas _____

Oil _____

Total Depth _____

PRODUCTION

1st 24 hrs. Nat. _____

1st 24 hrs. after shot _____

Gas _____ cu. ft. _____

Dry Hole _____

Abandoned _____

Greenwood

Map No. **KANSAS** Sec. 23 Twp. 22 R. 11E

Well No. 1 Frankenhouser Farm


Holler Bros Company

250' Ft. from N. Line

_____ Ft. from S. Line

_____ Ft. from E. Line

250' Ft. from W. Line

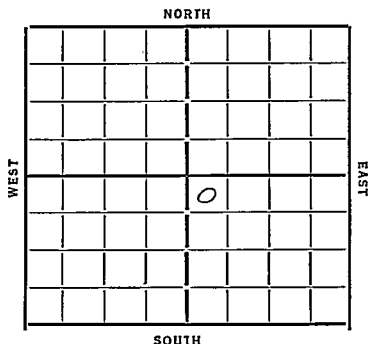

Date 1933

REPORT

4/19 W. D. 585'

4/26 S. D. 585'

5/4 W. D. 830'

5/10 S. D. 985'

5/17 W. D. 1040'

5/24 S. D. 1040'

6/1 _____

6/18 _____

6/15 _____

6/21 _____

6/28 _____

7/10 W. D. & S. D. 1876'

COMPLETED

Greenwood
 21 **KANSAS** E
 Map No. Sec. 23 Twp. 22 R. 11

Well No. 1 *Fant House*
Hollis Bros Company

Contractor

FIRST REPORTS

250 Ft. from N. Line

Ft. from S. Line

Ft. from E. Line

250 Ft. from W. Line

SECTION PLAT

		o	

Location

Rig up

Drilling and Remarks:

Blg 585

RECORD

Cased.....in.,ft.

Sand.....

Gas.....

Oil.....

Total Depth.....

PRODUCTION

1st 24 hrs. Nat.....

1st 24 hrs. after shot.....

Gas.....Cu. Ft.

Dry Hole.....

Abandoned.....


Date

APR 19 1933 **CHAS. L. SHERWOOD**
 192 Scout

Greenwood
 Map No. _____ Sec. 23 Twp. 22 R. 11E
21
 Well No. 1 - Frankhouser
Hollis Bros Company

Contractor

SECTION PLAT

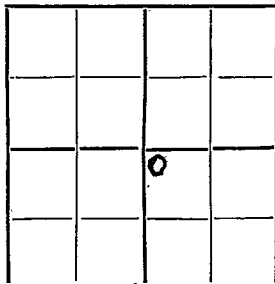250 Ft. from N. Line

_____ Ft. from S. Line

_____ Ft. from E. Line

250 Ft. from W. LineLocation **ABANDONED**

Rig up _____

Drilling and Remarks:

RECORD

Cased _____ in., _____ ft.

Sand _____

Gas _____

Oil _____

Total Depth _____

PRODUCTION

1st 24 hrs. Nat. _____

1st 24 hrs. after shot _____

Gas _____ Cu. Ft.

Dry Hole _____

Abandoned _____

Date

7/5/33 192 Oval Mannheim