

Greenwood


KANSAS

SECTION 23 TOWNSHIP 22S RANGE 11E

WELL NO. #1 Freeburg

COMPANY Marion Snyder

NORTH NW NW SW

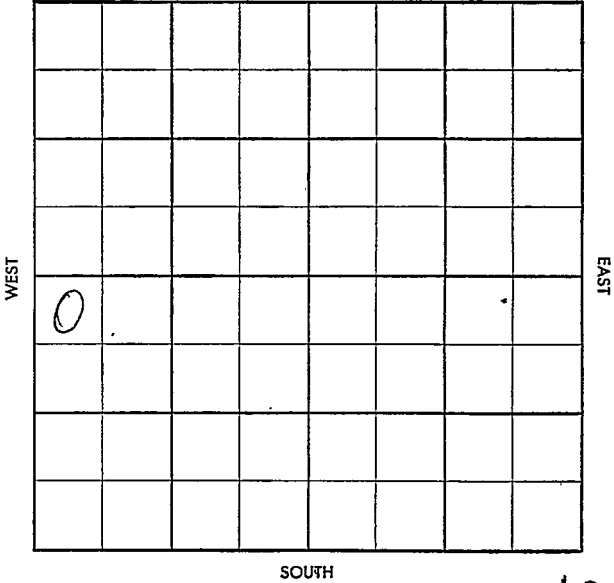

12

Handwritten mark

County Greenwood Elev. _____
 Sec. 22 Twp. 22 Rge. 11e
 Company Marion Snyder
 Farm Name Freeburg No. 1

Co.
Lse.
No.
Sec.
T.
R.

TOPS	DEPTH	LOG	DATUM
Anh.			
Tp.			
H.			
Tr.			
Dg.			
B.L.			
L.			
K.C.			
B.K.C.			
Ce.			
C.			
M.			
M.			
K.			
Mz.			
Mq.			
V.			
S.			
S.			
A.			
R.			
Pf.			
G.			
T.D.			

Loc. in Sec. _____
NW NW SW
 Geol. _____
 Contr. _____
Eureka Tools
 Pool _____
Madison

FIRST REPORT
 MAR 5 58

Date Comm. MI

~~Twp.~~ ~~Pool~~
~~Co.~~ ~~Facet~~

S-513 B

County Greenwood Elev. _____
 Sec. 23 Twp. 22 Rge. 11e
 Company Marion Snyder
 Farm Name Freeburg No. 1

TOPS	DEPTH	LOG	DATUM
Anh			
Tp.			
H.			
Tr.			
Dg			
B.L.	<u>BTU 12 1880</u>		
L.			
K.C.			
B.K.C.			
Ce.			
C.			
M.			
M.			
K.			
Mz.			
Mq.			
V.			
S.			
S.			
A.			
R.			
Pf.			
G.			
T.D.	<u>1897</u>		

Loc. in Sec. NW NW SW
 Geol. _____
 Contr. Eureka Tools
 Pool Madison

COMPLETE
 APR 30 '58

Date Comm. 4-2-58
 MI MAR 19 58 APR 9 58

8' 107 4 1/2" 1881
CD 1897 pop max
P/15 bsp + tv water
Bart

Co. No. Sec. T. R.