


Greenwood

KANSAS

SECTION 23 TOWNSHIP 22S RANGE 11E

WELL NO. #33 Madison Unit "C"

COMPANY C.S.O.

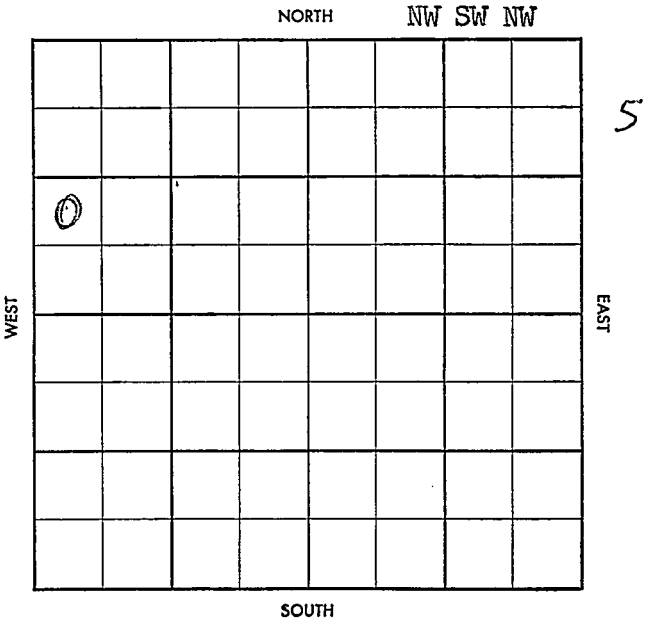



FIRST REPORT

CO. Greenwood ELEV. 1197RB  
SEC. 23 TWP. 22 RGE. 11E  
COMPANY C. S. G. NO. 33

OCT 16 57  
**COMPLETE**

FARM Madison Unit "C"

LOC. NW SW NW

Tops

Doug 818  
Lans. 994  
K.C. 1231  
BKG 1401  
Marm 1534  
B.Sd. 1891  
RTD 1938

GEOL. \_\_\_\_\_  
CONTR. \_\_\_\_\_  
POOL Madison  
SPUD 9-28-57  
10" @ 150 w/170, 7" @  
1891 w/100 CO 1918, P  
32 BO \* 12 BW/22

COMPLETE

CO.  
LSE.  
NO.  
SEC.  
TWP.  
RGE.