


Greenwood
 Map No. 174N Sec. 23 Twp. 22 R. 12
 Well No. 1 Frankhouser Farm
Callahan et al Company

NORTH

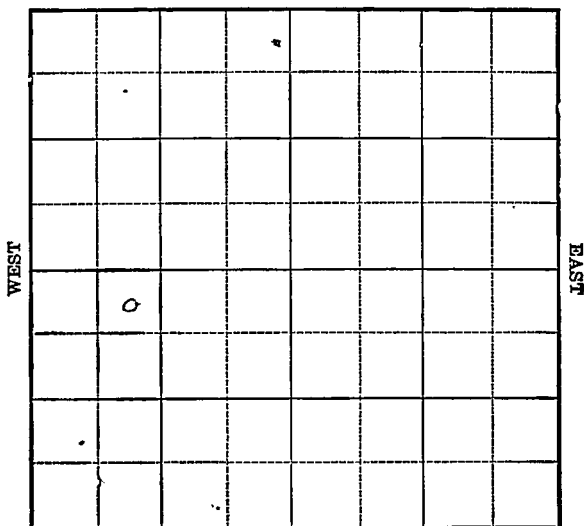

SOUTH

12

Location _____

Drilling Remarks _____

Rig Up _____

Drilling Remarks _____

RECORD

Cased _____ in. _____ ft.

Sand _____

Gas _____

Oil _____

Total Depth _____

PRODUCTION

1st 24 hrs. Nat. _____

1st 24 hrs. after shot _____

Gas _____ cu. ft.

Dry Hole _____


Abandoned _____

Greenwood

Map No. 19N Sec. 23 Twp. 22 R. 12¹¹Well No. 1 - Richards FarmCallahan et al Company330 Ft. from N. Line

Ft. from S. Line

Ft. from E. Line

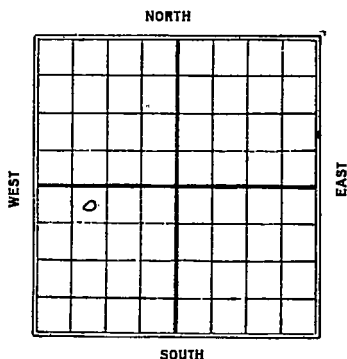990 Ft. from W. Line1926

Date

REPORT

8/25 Location
 8/31 Spuds
 9/16 Spudded to 500
 9/22 Drilg 500
 9/29 fishing 550
 10/13 S.D. 1000' for 10" csg.
 10/27 Drilg 1200'
 11/3 Sand 1860-1862
 top line 2050
 D. & A. 2092

Sherwood

21 Map No. KANSAS Sec. 22 Twp. 22 R. 12
 Well No. 1 J. H. Houser
 Callahan et al Company

Contractor

FIRST REPORTS

220 Ft. from N. Line

Ft. from S. Line

Ft. from E. Line

990 Ft. from W. Line

SECTION PLAT

o			

Location ✓

Rig up

Drilling and Remarks:

RECORD

Cased _____ in., _____ ft.

Sand _____

Gas _____

Oil _____

Total Depth _____

PRODUCTION

1st 24 hrs. Nat. _____

1st 24 hrs. after shot _____

Gas _____ Cu. Ft.

Dry Hole _____

Abandoned _____

Date

AUG 25 1926

CHAS. L. SHERWOOD

192 Scout

Shenwood

Map No. 21 Sec. 23 Twp. 22 R. 11Well No. 1 Richard
Callahan et al CompanyContractor
Confection

SECTION PLAT

0			

330 Ft. from N. Line

Ft. from S. Line

Ft. from E. Line

990 Ft. from W. Line

Location

Rig up

Drilling and Remarks:

SpudPreviously
Reported in Range
12. Chg to Range11. also for

RECORD

Cased _____ in., _____ ft.

Sand _____

Gas _____

Oil _____

Total Depth _____

PRODUCTION

1st 24 hrs. Nat. _____

1st 24 hrs. after shot _____

Gas _____ Cu. Ft.

Dry Hole _____

Abandoned _____

Date

9/1/26

192

Shenwood

Scout

21 KANSAS 23 Twp. 22 R. 11
 Map No. _____ Sec. _____

Well No. 1 Richards
 Callahan et al Company
 _____ Contractor

COMPLETED

330 Ft. from N. Line

_____ Ft. from S. Line

_____ Ft. from E. Line

990 Ft. from W. Line

SECTION PLAT

0			

ABANDONED

Location _____

Rig up _____

Drilling and Remarks:

Tap line 2030'

184
 2092'

RECORD

Cased _____ in., _____ ft.

Sand 1860-1862

Gas _____

Oil _____

Total Depth 2092

PRODUCTION

1st 24 hrs. Nat. _____

1st 24 hrs. after shot _____

Gas _____ Cu. Ft.

Dry Hole ✓

Abandoned _____

Date

NOV 3 1926

CHAS. L. SHERWOOD

Scout