

Marion

Map No. *Kans* Sec. *24* Twp. *22* R. *3^E*

Well No. *1 - Hall* Farm


Phillips Pet Company

300 Ft. from N. Line

..... Ft. from S. Line

..... Ft. from E. Line

300 Ft. from W. Line

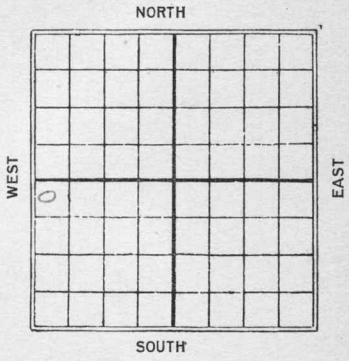

C.

Date	REPORT
<i>1925</i>	
<i>1/14</i>	<i>Location</i>
<i>1926</i>	
<i>9/17</i>	<i>Location Abnd</i>
	<p><i>was abandoned 2870</i></p> <p><i>Supply Records</i></p> <p><i>Ticket covering</i></p>

Map No. **KANSAS** Sec. *24* Twp. *22* R. *3 E*

Well No. *1-18 all*

Phillips Pet Company

Contractor

FIRST REPORT

SECTION PLAT

300 Ft. from N. Line

----- Ft. from S. Line

----- Ft. from E. Line

300 Ft. from W. Line

<i>0</i>			

Location *LL*

Rig up -----

Drilling and Remarks:

RECORD

Cased ----- in., ----- ft.

Sand -----

Gas -----

Oil -----

Total Depth -----

PRODUCTION

1st 24 hrs. Nat. -----

1st 24 hrs. after shot -----

Gas ----- Cu. Ft.

Dry Hole -----

Abandoned -----

Date

1/14 192*5*

M. A. BENEAR

Scout

Marion
24 **KANSAS** Sec. *24* Twp. *22* R. *3E*

Well No. *1 Hall*

Phillips Pet. Company

Contractor

SECTION PLAT

300 Ft. from N. Line

----- Ft. from S. Line

----- Ft. from E. Line

300 Ft. from W. Line

<i>0</i>			

ABANDONED

Location -----

Rig up -----

Drilling and Remarks:

Location

J. H. H.

DISCOVERED

EDUCED

STRAWN

GMV 4016

RECORD

Cased ----- in., ----- ft.

Sand -----

Gas -----

Oil -----

Total Depth -----

PRODUCTION

1st 24 hrs. Nat. -----

1st 24 hrs. after shot -----

Gas ----- Cu. Ft.

Dry Hole -----

Abandoned -----

Date

SEP 17 1920

192

S. J. LEWIS Scout

K24 KANSAS 24 TWP. 27S R. 3E
MAP NO. SEC. TWP. R.

WELL NO.
Phillips Pit COMPANY

CONTRACTOR

SECTION PLAT

ABANDONED

_____ FT. FROM N. LINE
_____ FT. FROM S. LINE
_____ FT. FROM E. LINE
_____ FT. FROM W. LINE

0			

No Record
only abandoned Location

LOCATION _____

RECORD

RIG UP _____

CASED _____ IN. _____ FT.

DRILLING AND REMARKS:

SAND _____

GAS _____

OIL _____

TOTAL DEPTH 2870

2785 by Lewis
2870 H. V.
Am abandoning
2870 by gas
records

PRODUCTION

1ST 24 HRS. NAT. _____

1ST 24 HRS. AFTER SHOT _____

GAS _____ CU. FT.

DRY HOLE ✓

ABANDONED ✓

DATE 4/17 1925 SCOUT