
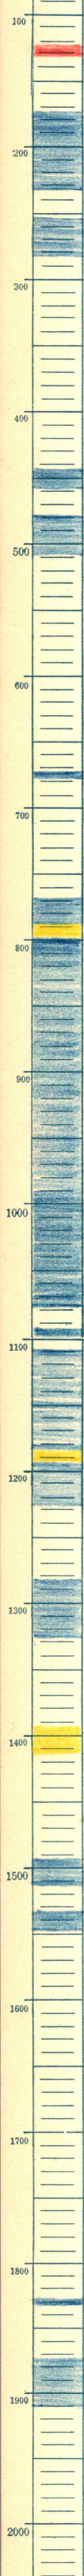


Kansas S. 24 T. 22 S., R. 13 E.
 Coffey County
 Company
 Peter Kraft #2 Farm
 T.D. 1910

Relation by
 drilled

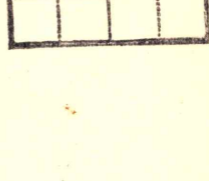

W.

- 98. H.F.W.

- 93
 - 13 Bartles sand.

- 93
 - 13 G. B.W.

- 33
 - 48

- 28
 - 32

- 73

- 1910 H.F.W.