


Map No. \_\_\_\_\_ Sec. 24 Twp. 22 R. 12

Well No. 4 - Frankhouser Farm  
Darby et al Company

NORTH

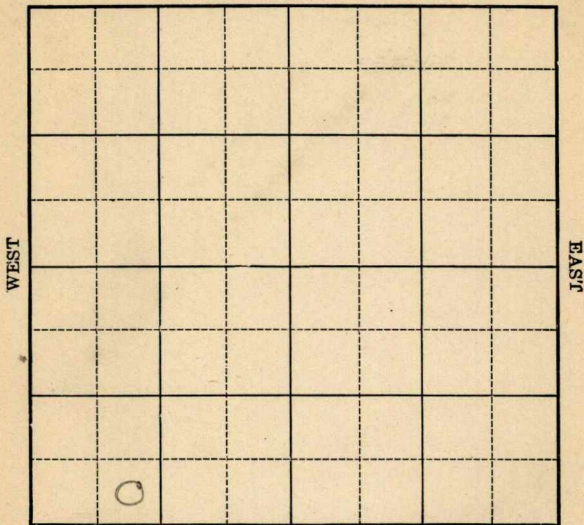

SOUTH

Location \_\_\_\_\_

Drilling Remarks \_\_\_\_\_

Rig Up \_\_\_\_\_

Drilling Remarks \_\_\_\_\_

**RECORD**

Cased \_\_\_\_\_ in. \_\_\_\_\_ ft.

Sand \_\_\_\_\_

Gas \_\_\_\_\_

Oil \_\_\_\_\_

Total Depth \_\_\_\_\_

**PRODUCTION**

1st 24 hrs. Nat. \_\_\_\_\_

1st 24 hrs. after shot \_\_\_\_\_

Gas \_\_\_\_\_ cu. ft.

Dry Hole \_\_\_\_\_

Abandoned \_\_\_\_\_



*Sherwood*

Map No. **21 KANSAS** Sec. *24* Twp. *22* R. *12*

Well No. *4 Jonkhauser*

*Darby et al* Company

Contractor

**COMPLETED**

**SECTION PLAT**

----- Ft. from N. Line

*330* Ft. from S. Line

----- Ft. from E. Line

*990* Ft. from W. Line

<i>o</i>			

Location -----

Rig up -----

Drilling and Remarks:

*2107 275 lbs.*

**RECORD**

Cased *1646-1699* in., ----- ft.

Sand -----

Gas -----

Oil -----

Total Depth *1699*

**PRODUCTION**

1st 24 hrs. Nat. -----

1st 24 hrs. after shot -----

Gas ----- Cu. Ft.

Dry Hole -----

Abandoned -----

Date

**NOV 9 - 1927**

**CHAS. L. SHERWOOD**

----- 192 -----

----- Scout

*Sherwood* ✓

Map No. **KANSAS** Sec. *24* Twp. *22* R. *12*

Well No. *4* *Jonsheuser*

*Darby et al* Company

Contractor

**FIRST REPORTS**

----- Ft. from N. Line

*330* Ft. from S. Line

----- Ft. from E. Line

*990* Ft. from W. Line

**SECTION PLAT**

<i>0</i>			

Location -----

Rig up ----- ✓

Drilling and Remarks:

**RECORD**

Cased ----- in., ----- ft.

Sand -----

Gas -----

Oil -----

Total Depth -----

**PRODUCTION**

1st 24 hrs. Nat. -----

1st 24 hrs. after shot -----

Gas ----- Cu. Ft.

Dry Hole -----

Abandoned -----

Date

**OCT 12 1927 CHAS. L. SHERWOOD**