
Form 51—5M—7-25—19786 Kansas Grunwood Co

Map No. / Sec. 24 Twp. 22 R. 14

Well No. 1 Trotell Farm

Trotell etal Company

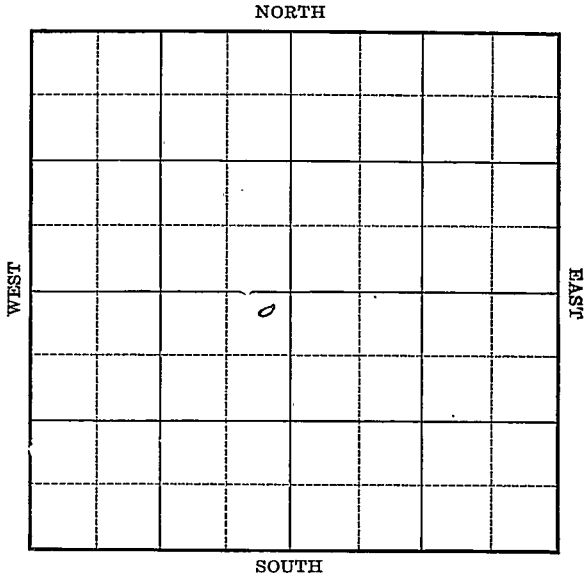

Location

Drilling Remarks

Rig Up

Drilling Remarks

RECORD

Cased in. ft.

Sand

Gas

Oil

Total Depth

PRODUCTION

1st 24 hrs. Nat.

1st 24 hrs. after shot

Gas cu. ft.

Dry Hole

Abandoned

Form 252A—5M—7-25—19684 Greenwood Co.

Map No. Kansas Sec. 24 Twp. 22 R. 10

Well No. 1 Trotell Farm


Trotell etal Company

330 Ft. from N. Line

_____ Ft. from S. Line

330 Ft. from E. Line

_____ Ft. from W. Line

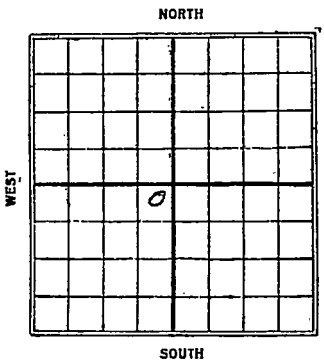

Date 1925	REPORT
12/10	Bldg Rig
12/17	Rig
12/23	"
12/31	Spudding
1926	
1/8	Drlg 700'
1/14	" 1200'
1/20	Abandoned 2223

Form 26—1M Bks.—3-23—11959. Glenwood Oil


Map No. KANSAS Sec. 21 34 Twp. 22 R. 10

Well No. 1 Troxell

Troxell et al Company

Contractor

SECTION PLAT

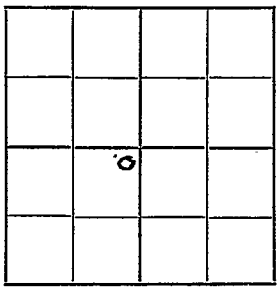

330 Ft. from N. Line

Ft. from S. Line

330 Ft. from E. Line

Ft. from W. Line

FIRST REPORTS

Location

Rig up

Drilling and Remarks:

Bldg Rig.

RECORD

Cased in., ft.

Sand

Gas

Oil

Total Depth

PRODUCTION

1st 24 hrs. Nat.

1st 24 hrs. after shot

Gas Cu. Ft.

Dry Hole

Abandoned

Date

DEC 10 1925 192

CHAS. L. SHERWOOD Scout

Form 26—1M Bks.—3-23—11959. Sherwood Co

IC21

Map No. KANSAS Sec. 24 Twp. 22 R. 10

Well No. 1 Moxell

Moxell et ux Company

Contractor

COMPLETED

330 Ft. from N. Line


Ft. from S. Line

330 Ft. from E. Line

Ft. from W. Line

ABANDONED

SECTION PLAT

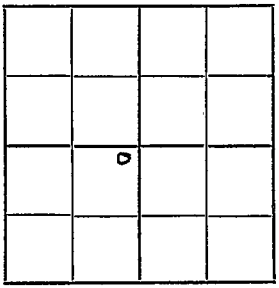

Location

Rig up

Drilling and Remarks:

Top Lime 2212'

Dry & shot

T. D. 2223'

RECORD

Cased in., ft.

Sand 2175- 2180' Dry

Gas

Oil

Total Depth 2223'

PRODUCTION

1st 24 hrs. Nat.

1st 24 hrs. after shot

Gas Cu. Ft.

Dry Hole ✓

Abandoned

Date

JAN 20 1926 192

CHAS. L. SHERWOOD Scout