
Form 51—5M—4-27—27423

Map No. _____ Sec. 24 Twp. 22 R. 12

Well No. 2 c - Fankhouser Farm

Empire Dr. Fl. Company

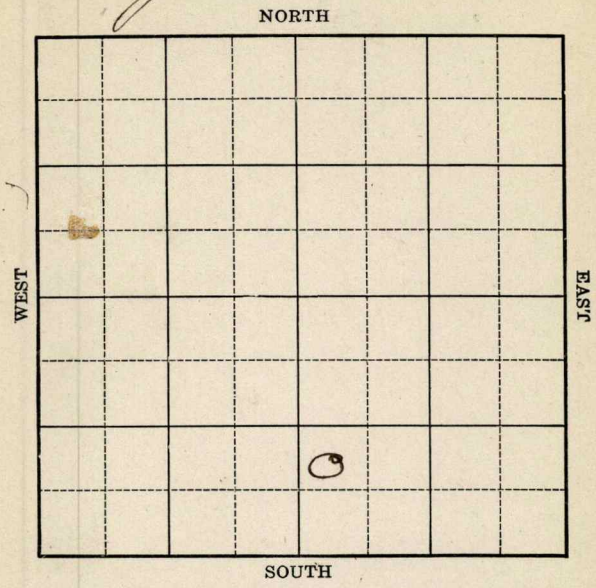

Location	Rig Up
Drilling Remarks	Drilling Remarks


RECORD		PRODUCTION	
Cased	in. ft.	1st 24 hrs. Nat.	
Sand		1st 24 hrs. after shot	
Gas		Gas	cu. ft.
Oil		Dry Hole	
Total Depth		Abandoned	

Form 252A—5M—4-27—27425

Map No. K Sec. 24 Twp. 22 R. 12

Well No. 2-C - Frankhouser Farm

Empire G. F. Company

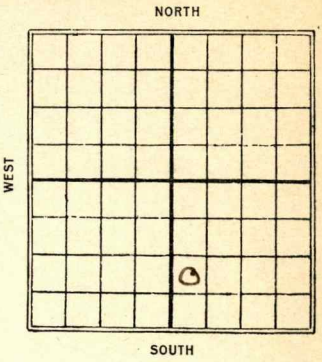

Ft. from N. Line

990 Ft. from S. Line

Ft. from E. Line

330 Ft. from W. Line

1927

Date	REPORT
8/3	Spudding 275'
8/10	Drlg 950
8/18	" 1370'
8/24	Sandy Shale 1681-1708 Show oil 1701-08 - Shale 1708-13 - Shot 60 qts 1699-1708 - Small show, top lime 1800 - S. Dorda
9/1	Drlg 2100-
9/7	Casing trouble 2210-
9/14	Sdy Shale 1681-1708 Show 1701-08 60/1699-1708-Show Top lime 1800 Top Wilcox 2196-2222 T.D. 2222- H.F.W. Abandoned

Form 26—1M Bks.—3-23—11959. Sherwood

21 KANSAS

Map No. _____ Sec. 24 Twp. 22 R. 12


Well No. 2C Lonkhouser

Empire Gas & Co Company

_____ Contractor

COMPLETED

SECTION PLAT

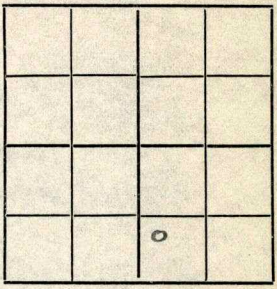

_____ Ft. from N. Line

990 Ft. from S. Line

_____ Ft. from E. Line

330 Ft. from W. Line

ABANDONED

Location _____

Rig up _____

Drilling and Remarks:

Shy Shale 1681-1708
Shows 1701-08
Log 1699-1708 Shows
Top Lime 1800
Top Wilcox 2196-2222

RECORD

Cased _____ in., _____ ft.

Sand _____

Gas _____

Oil _____

Total Depth 2222 ft.

PRODUCTION

1st 24 hrs. Nat. _____

1st 24 hrs. after shot _____

Gas _____ Cu. Ft.

Dry Hole ✓

Abandoned _____

Date

SEP 14 1927

_____ 192_ CHAS. L. SHERWOOD _____ Scout

Form 26—1M Bks.—3-23—11959. C. L. Sherwood

Map No. 21 KANSAS Sec. 24 Twp. 22 R. 12

Well No. A 2c Fonshouser

Empire Gas & Fuel Co
Company

Contractor

FIRST REPORTS


_____Ft. from N. Line

990 Ft. from S. Line

_____Ft. from E. Line

330 Ft. from W. Line

SECTION PLAT

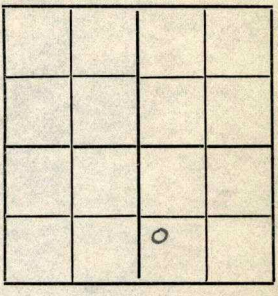

Location _____

Rig up _____

Drilling and Remarks:

Spdd 275'

RECORD

Cased _____in., _____ ft.

Sand _____

Gas _____

Oil _____

Total Depth _____

PRODUCTION

1st 24 hrs. Nat. _____

1st 24 hrs. after shot _____

Gas _____Cu. Ft.

Dry Hole _____

Abandoned _____

Date

AUG 3 1927

_____192___.

CHAS. L. SHERWOOD
_____Scout