


Map No. 15 Sec. 24 Twp. 22 R. 11

Well No. 1-Braddock Farm
Fisher-Laucke & White Company

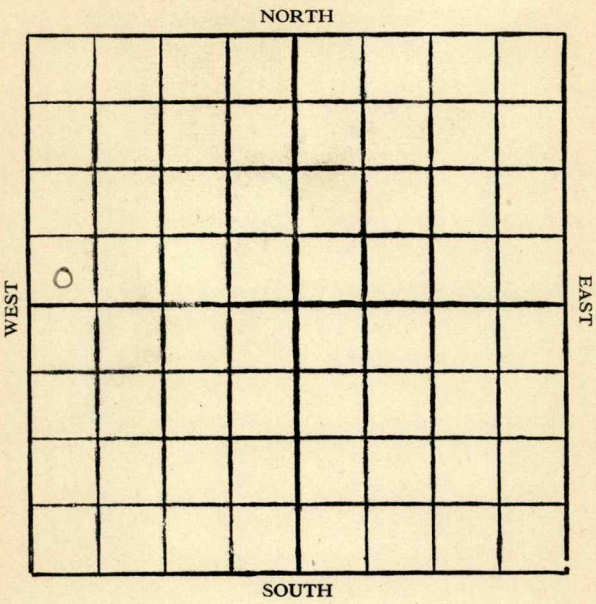

Location

Drilling Remarks

.....

.....

RECORD

Cased in. ft.

Sand

Gas

Oil

Total Depth

Rig Up.....

Drilling Remarks

.....

.....

PRODUCTION

1st 24 hrs. Nat.

1st 24 hrs. after shot

Gas cu. ft.

Dry Hole

Abandoned

Greenwood

Map No. Kansas Sec. 24 Twp. 22 R. 11E

Well No. 1 Braddock Farm


Fisher Laucke & White Company
Eagle

..... Ft. from N. Line

330 Ft. from S. Line

..... Ft. from E. Line

330 Ft. from W. Line

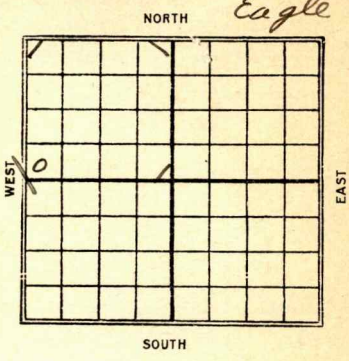

| Date | REPORT |
|------|---------------------------|
| 1927 | |
| 1/19 | Location |
| 1/26 | Same |
| 2/3 | Rig |
| 2/10 | — |
| 2/17 | Rigging up |
| 2/24 | Drlg 1350 |
| 3/2 | sandy shale 1816-25 |
| | Top line 1983 - Drlg 1988 |
| 3/9 | Top line 1983 |
| | sdy shale 1816-25 |
| | N.A. 2175 |
| | |
| | |
| | |
| | |
| | |
| | |
| | |
| | |
| | |

Sherwood

21 KANSAS

Map No. _____ Sec. *24* Twp. *22* R. *11*

Well No. *1* _____

Fisher-Lewis & White Eagle Company

Contractor

COMPLETED

SECTION PLAT

_____ Ft. from N. Line

330 Ft. from S. Line

_____ Ft. from E. Line

330 Ft. from W. Line

| | | | |
|----------|--|--|--|
| | | | |
| <i>0</i> | | | |
| | | | |
| | | | |

ABANDONED

Location _____

Rig up _____

Drilling and Remarks:

Tap line 1983
Qty shale 1816-25
DPH
2175

RECORD

Cased _____ in., _____ ft.

Sand _____

Gas _____

Oil _____

Total Depth *2175*

PRODUCTION

1st 24 hrs. Nat. _____

1st 24 hrs. after shot _____

Gas _____ Cu. Ft.

Dry Hole

Abandoned

Date

MAR 9 1927 CHAS. L. SHERWOOD

192

Scout

Sherwood

E

Map No. 21 **KANSAS** Sec. 24 Twp. 22 R. 11

Well No. 1 *Draddock*
Fisher-Lancuse & White Eagle Company

Contractor

FIRST REPORTS

SECTION PLAT

----- Ft. from N. Line

330

----- Ft. from S. Line

----- Ft. from E. Line

330

----- Ft. from W. Line

| | | | |
|--|--|--|--|
| | | | |
| | | | |
| | | | |
| | | | |

Location -----

Rig up -----

Drilling and Remarks:

RECORD

Cased ----- in., ----- ft.

Sand -----

Gas -----

Oil -----

Total Depth -----

PRODUCTION

1st 24 hrs. Nat. -----

1st 24 hrs. after shot -----

Gas ----- Cu. Ft.

Dry Hole -----

Abandoned -----

Date

JAN 19 1927

CHAS. L. SHERWOOD