


Map No. **KANSAS** Sec. 24 Twp. 22 R. 11 ^E
Well No. 1 Bradson Farm
Empire C & R Company

330 Ft. from N. Line
..... Ft. from S. Line
..... Ft. from E. Line
330 Ft. from W. Line

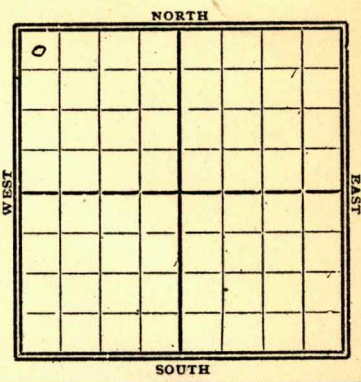

1928

Date	REPORT
8/22	R.O.H.
8/28	Spdy.
9/4	Hrlg 845
9/12	" 1350
9/19	sdy shale 1815-20
	Top line 2010 drlg.
9/26	sandy shale 1815-20'
	T.L. 2010'
	Dry & Aband 2020'
	<u>Aband.</u>

Greenwood

MAP No. 21 **KANSAS** SEC. 24 TWP. 22 R. 11 ^E

WELL No. 1 *Brassock*
Empire Oil Co COMPANY

CONTRACTOR

FIRST REPORTS

330 FT. FROM N. LINE
____ FT. FROM S. LINE
____ FT. FROM E. LINE
330 FT. FROM W. LINE

SECTION PLAT

0			

LOCATION _____

RIG UP _____

DRILLING AND REMARKS:

ROS

RECORD

CASED _____ IN. _____ FT.
SAND _____
GAS _____
OIL _____
TOTAL DEPTH _____

PRODUCTION

1ST 24 HRS. NAT. _____
1ST 24 HRS. AFTER SHOT _____
GAS _____ CU. FT.
DRY HOLE _____
ABANDONED _____

DATE

AUG 22 1928

CHAS. L. SHERWOOD

192

SCOUT

Sherwood

K21 KANSAS MAP NO. _____ SEC. 24 TWP. 22 R. 11

WELL No. 1 Broadway
Empire Oil COMPANY

CONTRACTOR _____

COMPLETED

SECTION PLAT

330 FT. FROM N. LINE
____ FT. FROM S. LINE
____ FT. FROM E. LINE
330 FT. FROM W. LINE

0			

ABANDONED

LOCATION _____

RIG UP _____

DRILLING AND REMARKS:

Sdy shab 1815-20'
KL 2010'
DW 2020'

RECORD

CASED _____ IN. _____ FT.

SAND _____

GAS _____

OIL _____

TOTAL DEPTH 2020

PRODUCTION

1ST 24 HRS. NAT. _____

1ST 24 HRS. AFTER SHOT _____

GAS _____ Cu. Ft.

DRY HOLE _____

ABANDONED _____

DATE

SEP 26 1928

CHAS. L. SHERWOOD

192 _____ SCOUT