

Section 25 Township 22 Range 3E

Well No. #1 Moffett

Company Simon Cohen  
~~H.J. Uhl Drig. et al~~

NORTH

							0

WEST

EAST

SOUTH

Marion KANSAS

SEC.	TWP.	R.
25	22	3E

WELL NO. 1 Moffett FARM

COMPANY *Simon Cohen*  
~~H. J. Uhl Drilg. et al~~

CONTRACTOR Co. Tools

Edmonds Ext. Pool

_____ Ft. from N. Line	
330 _____ Ft. from S. Line	
330 _____ Ft. from E. Line	
_____ Ft. from W. Line	

SE SE SE

	ELEVATION	REPORT
1955	1414'	
1/19	MIR	
4/20	Spud 1-22-55 - D&A TD 2518' 8" @ 90' KC 1940', Miss. 2505' TD 2508' 5" @ 2507' Lans. 1904', B KC 2281', Marm. 2348', Cherokee 2484' DD 2518' B/55 go 35" PB 2515' Sd-frac, S/wtr. D&A	
		<b>ABANDONED</b>


County Marion State Kansas

Sec. 25 (Blk. 22 (Sur. 3E (Twp.) (Rge.) Map No.

Operator H. J. Uhl Drlg. etal.

Well No. 1 Farm Moffett

Elev. Location SE SE SE

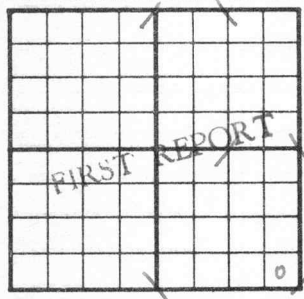

330 Ft. From S Line SE

330 Ft. From E Line Quarter

1st. Report JAN 19 1955

Completion \_\_\_\_\_

Remarks \_\_\_\_\_

Co. tools

Spudding Date \_\_\_\_\_

Drlg. Data Edmonds Ext. Pool

M I R

FABEN GILSTRAP

# SCOUT TICKET

DX-201

Kansas

SEC.	TWP.	R.
25	22	3E

WELL NO.

1 Moffett

FARM

COMPANY

Simon Cohen

CONTRACTOR

CONNECTION


SE SE SE

\_\_\_\_\_ FT. FROM N. LINE

330 FT. FROM S. LINE

330 FT. FROM E. LINE

\_\_\_\_\_ FT. FROM W. LINE

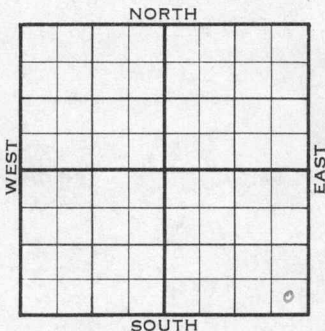

Marion County

<input type="checkbox"/> LOCATION <input type="checkbox"/> RIG UP DRILLING AND REMARKS:  Reported H. J. Uhl et al.	RECORD	CASED IN., FT.
		SAND
	PRODUCTION	GAS
		OIL
		TOTAL DEPTH
		1ST 24 HRS. NAT.
		1ST 24 HRS. AFTER SHOT
		GAS CU. FT.
		DRY HOLE
		ABANDONED

DATE

FEB 9 1955

SCOUT

FABEN GILSTRAP


County Marion State Kansas

Sec. 25 (Blk. 22 (Sur. Rge.) 3E Map No.

Operator Simon Cohen

Well No. 1 Farm Moffett

Elev. 1414 Location SE SE SE

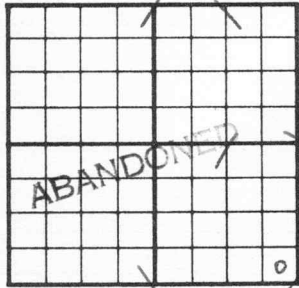

330 Ft. From S Line SE

330 Ft. From E Line Quarter

1st. Report

Completion APR 20 1955

Remarks Edmonds Ext.

Co. tools

Spudding Date 1-22-55

Drlg. Data D & A TD 2518

8" @ 90 KC 1940 Miss. 2505 TD 2508

5" @ 2507 Lans. 1904 B KC 2281

Marm. 2348 Cherokee 2484 DD 2518

B/ 55 go 35 min. PB 2515 sd-frac

S/ wtr.

D & A