



Chase

Form 252-A  
5M 4-32 MPC

Map No. KANSAS Sec. 25 Twp 22 R. 9E


Well No. 1 Leedy Farm  
Slick Pryor & Lockhart Company

\_\_\_\_\_ Ft. from N. Line

250 Ft. from S. Line

\_\_\_\_\_ Ft. from E. Line

250 Ft. from W. Line

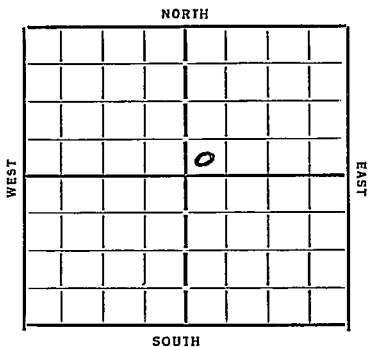

Date	REPORT
1924	
5/2	Location
5/10	—
5/18	Rig
5/25	—
5/31	Spud
6/7	Dly 675
6/14	Dly 610
6/21	Dly 850
6/28	" 1510
7/5	" 1730
7/12	" 1945
7/19	" 2020
7/26	Bart. 2426 TD 2428 Run 6"
8/2	Bore B. Sand 2486
	Flow 140 Bbls 24 hrs.
	shot 10 gts Pipe trouble
8/8	Sand 2426 TD 2486
	Shot 10 gts 150 Bbls.

COMPLETED

Map No. 22 Sec. 25 Twp. 22 R. 9E

Well No. 1 - Leedy  
Slick, Perry or Lockhart Company

Contractor

FIRST REPORTS

SECTION PLAT

\_\_\_\_\_ Ft. from N. Line

250 Ft. from S. Line

\_\_\_\_\_ Ft. from E. Line

250 Ft. from W. Line

		o	

Location ✓

Rig up \_\_\_\_\_

Drilling and Remarks:

RECORD

Cased \_\_\_\_\_ in., \_\_\_\_\_ ft.

Sand \_\_\_\_\_

Gas \_\_\_\_\_

Oil \_\_\_\_\_

Total Depth \_\_\_\_\_

PRODUCTION

1st 24 hrs. Nat. \_\_\_\_\_

1st 24 hrs. after shot \_\_\_\_\_

Gas \_\_\_\_\_ Cu. Ft.

Dry Hole \_\_\_\_\_

Abandoned \_\_\_\_\_

Date

5-2-34

19

ORVAL MANNSCHRECK

Scout

*Chase*  
 Map No. 22 Sec. 25 Twp. 22 R. 9E  
 Well No. 1- Leedy  
Slick Jerry Oil & Fuel Company  
 Contractor

**COMPLETED**

SECTION PLAT

		0	

\_\_\_\_\_ Ft. from N. Line  
250 Ft. from S. Line  
 \_\_\_\_\_ Ft. from E. Line  
250 Ft. from W. Line

Location \_\_\_\_\_

Rig up \_\_\_\_\_

Drilling and Remarks:

*shot 10 pts*

*150 hbls*

RECORD

Cased \_\_\_\_\_ in. \_\_\_\_\_ ft.  
 Sand 2426  
 Gas \_\_\_\_\_  
 Oil \_\_\_\_\_  
 Total Depth 2486

PRODUCTION

1st 24 hrs. Nat. \_\_\_\_\_  
 1st 24 hrs. after shot \_\_\_\_\_  
 Gas \_\_\_\_\_ Cu. Ft.  
 Dry Hole \_\_\_\_\_  
 Abandoned \_\_\_\_\_

Date

8-8-34 19