

Chase

Map No. KANSAS Sec. 25 Twp. 22 R. 9E


Well No. 4- Lecky Farm _____
Slick M & L Company _____

_____ Ft. from N. Line

990 Ft. from S. Line

_____ Ft. from E. Line

990 Ft. from W. Line

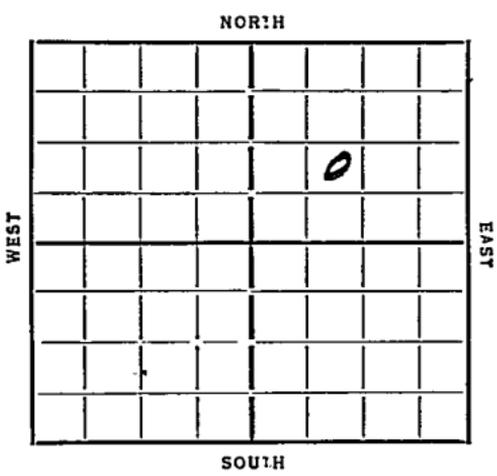

Date

REPORT

7/25

8/21

8/29

9/6

10/2

Bldg Rig

Moving

Sand 2570-95

TL 2583-87

T7 2587

D & A.

ABANDONED

Map No. 22 Sec. 25 Twp. 22 R. 9E

Well No. 4 - Judy

Blisk P & L Company

Contractor

FIRST REPORTS

SECTION PLAT

..... Ft. from N. Line

990 Ft. from S. Line

..... Ft. from E. Line

990 Ft. from W. Line

		0	

Location.....

Rig up.....

Drilling and Remarks:

Bud Rig

RECORD

Cased.....in.,ft.

Sand.....

Gas.....

Oil.....

Total Depth.....

PRODUCTION

1st 24 hrs. Nat.....

1st 24 hrs. after shot.....

Gas.....Cu. Ft.

Dry Hole.....

Abandoned.....

Date

8-21-35 192

ORVAL MANNSCHRECK

Scout

Map No. 22 Sec. 25 Twp. 22 R. 9E

Well No. 4 - Judy

Chick Pryor & Lockhart Company

Contractor

ABANDONED

SECTION PLAT

		0	

.....Ft. from N. Line

990 Ft. from S. Line

.....Ft. from E. Line

990 Ft. from W. Line

Location.....

Rig up.....

Drilling and Remarks:

10 + A

RECORD

Cased.....in.,ft.

Sand 2570-75

Gas TL 2583-87

Oil.....

Total Depth 2587

PRODUCTION

1st 24 hrs. Nat.....

1st 24 hrs. after shot.....

Gas.....Cu. Ft.

Dry Hole.....

Abandoned.....

Date

JOHN L. MANSCHRENE

10-2-35 192.....

Scout