




Map No. \_\_\_\_\_ Sec. 25 Twp. 22 R. 12  
 Well No. 2-ott Farm \_\_\_\_\_  
Empire G. & F. Company

NORTH

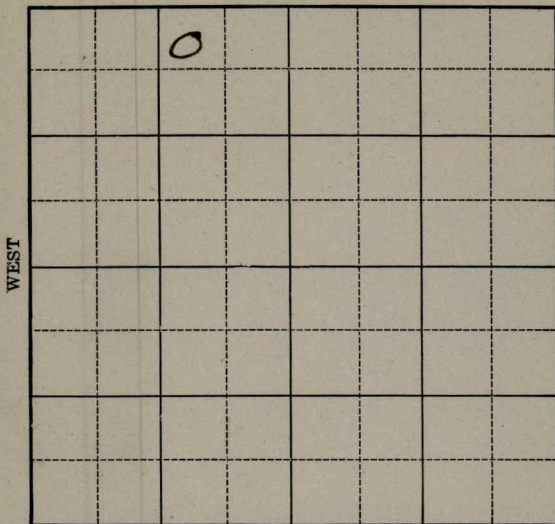

3

Location \_\_\_\_\_

Drilling Remarks \_\_\_\_\_

Rig Up \_\_\_\_\_

Drilling Remarks \_\_\_\_\_

**RECORD**

Cased \_\_\_\_\_ in. \_\_\_\_\_ ft.

Sand \_\_\_\_\_

Gas \_\_\_\_\_

Oil \_\_\_\_\_

Total Depth \_\_\_\_\_

**PRODUCTION**

1st 24 hrs. Nat. \_\_\_\_\_

1st 24 hrs. after shot \_\_\_\_\_

Gas \_\_\_\_\_ cu. ft.

Dry Hole \_\_\_\_\_

Abandoned \_\_\_\_\_

Map No. \_\_\_\_\_ Sec. 25 Twp. 22 R. 12

Well No. 2 - ott Farm \_\_\_\_\_


Empire G. & F. Company

330 Ft. from N. Line

\_\_\_\_\_ Ft. from S. Line

990 Ft. from E. Line

\_\_\_\_\_ Ft. from W. Line

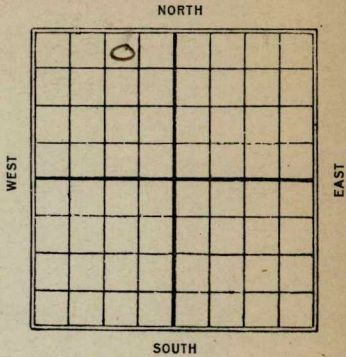

1927

Date	REPORT
8/3	Rigging up
8/10	Drilg 375
8/18	" 1370'
8/24	S.D. 1370
9/1	Pay 1680-1712
	210 gts/ 1665-1711
	500 bbls

*Sherwood*

Map No. 21 **KANSAS** Sec. 25 Twp. 22 R. 12

Well No. 2 OTT  
Empire Oil & Gas Co Company

Contractor

**FIRST REPORTS**

**SECTION PLAT**

330 Ft. from N. Line  
Ft. from S. Line  
990 Ft. from E. Line  
Ft. from W. Line

	0		

Location -----

Rig up -----

Drilling and Remarks:

*Rigging up*

**RECORD**

Cased \_\_\_\_\_ in., \_\_\_\_\_ ft.  
Sand \_\_\_\_\_  
Gas \_\_\_\_\_  
Oil \_\_\_\_\_  
Total Depth \_\_\_\_\_

**PRODUCTION**

1st 24 hrs. Nat. \_\_\_\_\_  
1st 24 hrs. after shot \_\_\_\_\_  
Gas \_\_\_\_\_ Cu. Ft.  
Dry Hole \_\_\_\_\_  
Abandoned \_\_\_\_\_

Date

**AUG 3 1927**

**CHAS. L. SHERWOOD**

1927 Scout

*Greenwood*

21 **KANSAS** Map No. Sec. 25 Twp. 22 R. 12

Well No. 2 *etc*  
*Empire Oil & Co* Company

Contractor

**COMPLETED**

**SECTION PLAT**

330 Ft. from N. Line  
Ft. from S. Line  
990 Ft. from E. Line  
Ft. from W. Line

	0		

Location

Rig up

Drilling and Remarks:

*Log 1680-1712*  
*210y 1665-1711*  
*500 Bl*

**RECORD**

Cased \_\_\_\_\_ in., \_\_\_\_\_ ft.  
Sand *1644-1712*  
Gas \_\_\_\_\_  
Oil \_\_\_\_\_  
Total Depth *1714*

**PRODUCTION**

1st 24 hrs. Nat. \_\_\_\_\_  
1st 24 hrs. after shot \_\_\_\_\_  
Gas \_\_\_\_\_ Cu. Ft.  
Dry Hole \_\_\_\_\_  
Abandoned \_\_\_\_\_

Date

**SEP 1 - 1927**

**CHAS. L. SHERWOOD**  
Scout