


Map No. **KANSAS** Sec. 25 Twp. 22 R. 12

Well No. 5-A-Ott Farm
Empire O.R. Company

NORTH

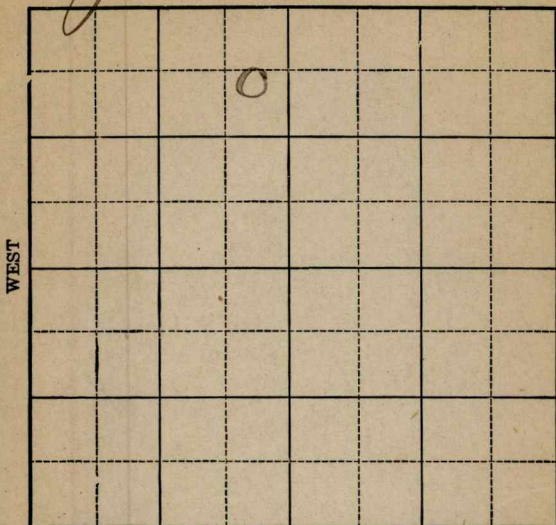

WEST

EAST

SOUTH

Location _____

Drilling Remarks _____

Rig Up _____

Drilling Remarks _____

RECORD

Cased _____ in. _____ ft.

Sand _____

Gas _____

Oil _____

Total Depth _____

PRODUCTION

1st 24 hrs. Nat. _____

1st 24 hrs. after shot _____

Gas _____ cu. ft.

Dry Hole _____

Abandoned _____

KANSAS

Map No. Sec. 25 Twp. 22 R. 12

Well No. 5-A-Ott Farm


Empire O. & R. Company

785 Ft. from N. Line

Ft. from S. Line

330 Ft. from E. Line

Ft. from W. Line

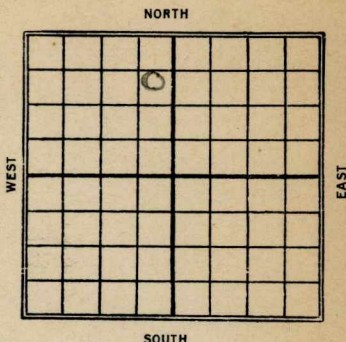

1927

Date

REPORT

Date	REPORT
12/21	R.O.G.
12/29	Rigging up
1/5	Spudding
1/11	Drilg 685
1/18	" 995
1/26	" 1387
2/1	sdly shale 1635-74
	sand 1674-1717
	240/150 bbls
	T.D. 1724'

Sherwood

21 KANSAS

Map No. _____ Sec. *25* Twp. *22* R. *12*

Well No. *5 A* *ott*

Empire Oil Co

Company

Contractor

FIRST REPORTS.

SECTION PLAT

785 Ft. from N. Line
_____ Ft. from S. Line
330 Ft. from E. Line
_____ Ft. from W. Line

Location _____

Rig up _____

Drilling and Remarks:

ROS

RECORD

Cased _____ in., _____ ft.
Sand _____
Gas _____
Oil _____
Total Depth _____

PRODUCTION

1st 24 hrs. Nat. _____
1st 24 hrs. after shot _____
Gas _____ Cu. Ft.
Dry Hole _____
Abandoned _____

Date

DEC 21 1927

CHAS. L. SHERWOOD

192

Scout

Sherwood

Map No. **21 KANSAS** Sec. **25** Twp. **22** R. **12**

Well No. **5A** **011**

Empire Oil Co Company

Contractor

COMPLETED

SECTION PLAT

785 Ft. from N. Line

Ft. from S. Line

330 Ft. from E. Line

Ft. from W. Line

Location

Rig up

Drilling and Remarks:

Sdy Shale 1635-74

2407 150 Bl.

RECORD

Cased _____ in. _____ ft.

Sand **1674-1717**

Gas _____

Oil _____

Total Depth **1724**

PRODUCTION

1st 24 hrs. Nat. _____

1st 24 hrs. after shot _____

Gas _____ Cu. Ft.

Dry Hole _____

Abandoned _____

Date **FEB 1 1928**

CHAS. L. SHERWOOD

192 Scout