


Map No. **KANSAS** Sec. 25 Twp. 22 R. 12  
Well No. 10A Ott Farm \_\_\_\_\_  
Empire Oil & R. Co. Company

NORTH

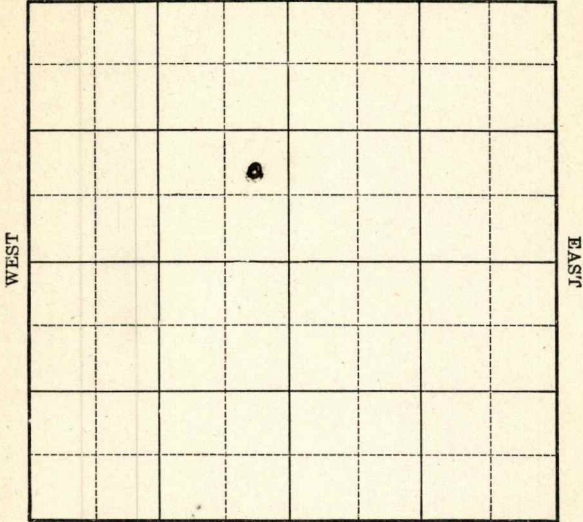

SOUTH

Location \_\_\_\_\_

Drilling Remarks \_\_\_\_\_

Rig Up \_\_\_\_\_

Drilling Remarks \_\_\_\_\_

**RECORD**

Cased \_\_\_\_\_ in. \_\_\_\_\_ ft.

Sand \_\_\_\_\_

Gas \_\_\_\_\_

Oil \_\_\_\_\_

Total Depth \_\_\_\_\_

**PRODUCTION**

1st 24 hrs. Nat. \_\_\_\_\_

1st 24 hrs. after shot \_\_\_\_\_

Gas \_\_\_\_\_ cu. ft.

Dry Hole \_\_\_\_\_

Abandoned \_\_\_\_\_

Map No. **KANSAS** Sec. 25 Twp. 22 R. 12

Well No. 10A - Ott Farm


Empire O. & R. Company

..... Ft. from N. Line

905 Ft. from S. Line

330 Ft. from E. Line

..... Ft. from W. Line

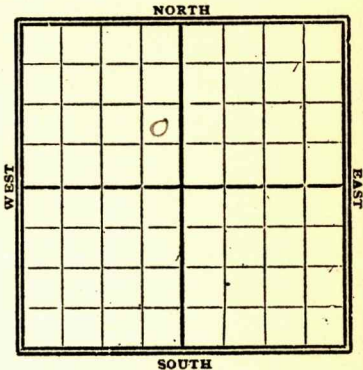

1928

Date

REPORT

7/25 Bldg Rig  
 8/2 Spudding  
 8/9 Drlg 800  
 8/16 " 1375  
 8/23 set 8" - 1540  
 8/30 sand 1665 - 1705  
 T.D. 1726  
 740/160 bbls  
 Comp

*Sherwood*

21 **KANSAS** SEC. 25 TWP. 22 R. 12

WELL No. 10 # 000

Empire Oil Co COMPANY

CONTRACTOR

**FIRST REPORTS**

**SECTION PLAT**

\_\_\_\_\_ FT. FROM N. LINE

905 \_\_\_\_\_ FT. FROM S. LINE

330 \_\_\_\_\_ FT. FROM E. LINE

\_\_\_\_\_ FT. FROM W. LINE

	o		

LOCATION *Boley Rig*

RIG UP

DRILLING AND REMARKS:

**RECORD**

CASED \_\_\_\_\_ IN. \_\_\_\_\_ FT.

SAND \_\_\_\_\_

GAS \_\_\_\_\_

OIL \_\_\_\_\_

TOTAL DEPTH \_\_\_\_\_

**PRODUCTION**

1ST 24 HRS. NAT. \_\_\_\_\_

1ST 24 HRS. AFTER SHOT \_\_\_\_\_

GAS \_\_\_\_\_ CU. FT.

DRY HOLE \_\_\_\_\_

ABANDONED \_\_\_\_\_

DATE

JUL 25 1928

**CHAS. L. SHERWOOD**

192

SCOUT

*Sherwood*

K 21 **KANSAS**

MAP NO. \_\_\_\_\_ SEC. 25 TWP. 22 R. 12

WELL NO. 10<sup>th</sup> Ott

*Empire*

COMPANY

CONTRACTOR

**SECTION PLAT**

**COMPLETED**

	0		

\_\_\_\_\_ FT. FROM N. LINE

905 FT. FROM S. LINE

330 FT. FROM E. LINE

\_\_\_\_\_ FT. FROM W. LINE

LOCATION \_\_\_\_\_

RIG UP \_\_\_\_\_

DRILLING AND REMARKS:

*1407160 BS.*

**RECORD**

CASED \_\_\_\_\_ IN. \_\_\_\_\_ FT.

SAND 1665-1705

GAS \_\_\_\_\_

OIL \_\_\_\_\_

TOTAL DEPTH 1726

**PRODUCTION**

1ST 24 HRS. NAT. \_\_\_\_\_

1ST 24 HRS. AFTER SHOT \_\_\_\_\_

GAS \_\_\_\_\_ CU. FT.

DRY HOLE \_\_\_\_\_

ABANDONED \_\_\_\_\_

DATE

**AUG 30 1928**

**CHAS. L. SHERWOOD**