

Greenwood

Map No. *100* Sec. *25* Twp. *22* R. *12*


Well No. *1* *Schwab* Farm
Empire G & F. Company

..... Ft. from N. Line

330 Ft. from S. Line

990 Ft. from E. Line

..... Ft. from W. Line

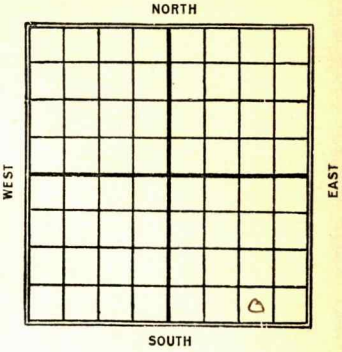

1926

Date REPORT

Date	REPORT
<i>9/1</i>	<i>1 P. O. G.</i>
<i>9/15</i>	<i>rigging up</i>
<i>9/22</i>	<i>Drill 330</i>
<i>9/29</i>	<i>" 700</i>
<i>10/13</i>	<i>" 1290.</i>
<i>10/27</i>	<i>Top line 1778' to 1900'</i>
<i>10/27</i>	<i>undereaming</i>
<i>11/11</i>	<i>Top Wilcox sand 2185-2187 filled up 1900' oil in 3 hrs Oil tests 28 gravity</i>
<i>11/17</i>	<i>Wilcox 2185-2187 Top Line 1778 355 bbls 28 grav.</i>

Sherwood

Map No. 21 **KANSAS** Sec. 25 Twp. 22 R. 12

Well No. 1 *Schwab*

Empire Oil & Gas Co. Company

Contractor

COMPLETED

SECTION PLAT

_____ Ft. from N. Line

330

_____ Ft. from S. Line

990

_____ Ft. from E. Line

_____ Ft. from W. Line

			<i>o</i>

Location _____ *Atlix*

Rig up _____

Drilling and Remarks:

th 1778

385 lbs.

28 gravity.

RECORD

Cased _____ in., _____ ft.

Sand *2185-2187*

Gas _____

Oil _____

Total Depth *2187*

PRODUCTION

1st 24 hrs. Nat. _____

1st 24 hrs. after shot _____

Gas _____ Cu. Ft.

Dry Hole _____

Abandoned _____

Date

NOV 17 1926

CHAS. L. SHERWOOD

Greenwood

21 KANSAS Map No. Sec. 25 Twp. 22 R. 12

Well No. 1 Schweb

Compilo base Fuel Company

Contractor

FIRST REPORTS

SECTION PLAT

330 Ft. from N. Line

990 Ft. from S. Line

Ft. from E. Line

Ft. from W. Line

			o

Correct Larm Name.

Location

Rig up

Drilling and Remarks:

ROS.

RECORD

Cased in., ft.

Sand

Gas

Oil

Total Depth

PRODUCTION

1st 24 hrs. Nat.

1st 24 hrs. after shot

Gas Cu. Ft.

Dry Hole

Abandoned

Date

SEP 1 1926

CHAS. L. SHERWOOD

192

Scout