
FORM 51 Greenwood KANSAS

Section 25 Township 22 Range 12 E

Well No. # 56 Schwab

Company Cities Service

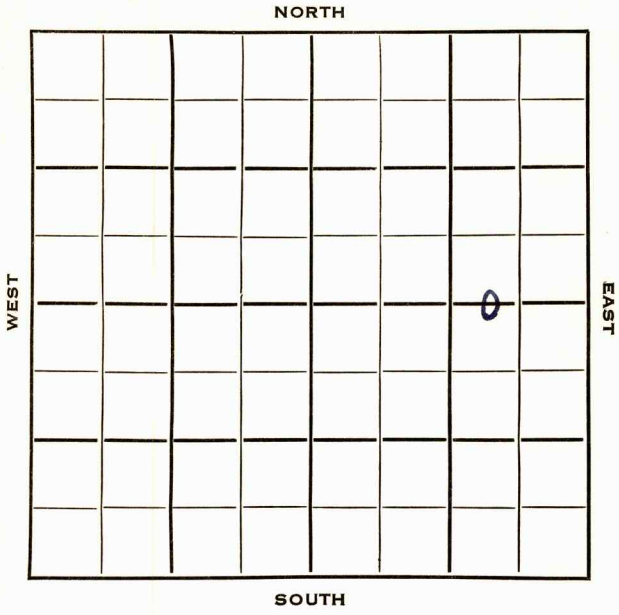

8

Greenwood KANSAS

SEC.	TWP.	R.
25	22	12E

WELL NO. #56 Schwab FARM

COMPANY Cities Service

CONTRACTOR


2640 Ft. from N. Line

Ft. from S. Line

950 Ft. from E. Line

Ft. from W. Line

Sec.

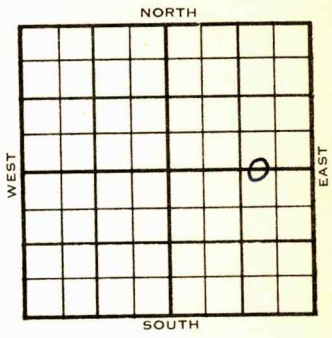

C W½ E½ E½

	ELEVATION	
1953	1106' RB	REPORT
11/18	Oil Well TD 1722' 8" @ 73' Bart 1695' 5" @ 1672' TD 1722' Comp 12 bopd 12 bw.	

FIRST REPORT

COMPLETED

DX-78

FORM 275 FOR SALE BY KANSAS BLUE PRINT CO.


County Greenwood State Kansas

Sec. 25 (Blk. Twp.) 22 (Sur. Rge.) 12E Map No.

Operator Cities Service

Well No. 56 Farm Schwab

Elev. 1106 RB Location C W½ E½ E½

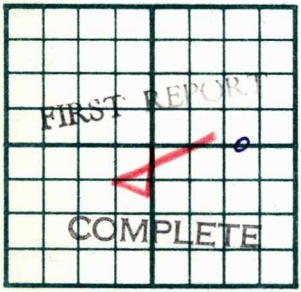

2640 Ft. From N Line Sec.

950 Ft. From E Line Quarter

1st. Report NOV 18 1953

Completion NOV 18 1953

Remarks

Spudding Date

Drlg. Data Oil well TD 1722

8" @ 73 Bart. 1695 5" @ 1672 TD 1722

Comp. 12 bopd 12 bw

J. G. McGEHEE