

Map No. _____ Sec. 25 Twp. 22 R. 12 E

Well No. 3 - Demler Farm _____


Empire Oil & R. Company _____

605 Ft. from N. Line

_____ Ft. from S. Line

114 Ft. from E. Line

_____ Ft. from W. Line

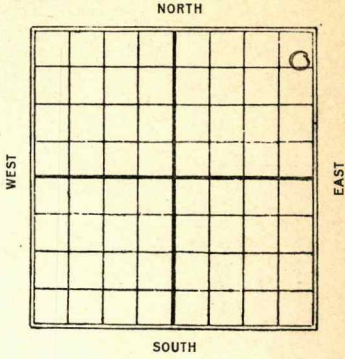

1927

Date

REPORT

<u>10/26</u>	<u>Bldg Rig</u>
<u>11/2</u>	<u>well 650'</u>
<u>11/9</u>	<u>" 1423-</u>
<u>11/16</u>	<u>1681-1735 T.D. 1738</u>
	<u>210/360 bbls</u>

Sherwood

21 **KANSAS** Map No. Sec. 25 Twp. 22 R. 12

Well No. 13
Empire Oil & Refg Co Company

Contractor

COMPLETED

SECTION PLAT

605 Ft. from N. Line
Ft. from S. Line
114 Ft. from E. Line
Ft. from W. Line

			o

Location -----
Rig up -----
Drilling and Remarks:

2107 360 lbs.

RECORD

Cased _____ in., _____ ft.
Sand 1681-1735
Gas -----
Oil -----
Total Depth 1738

PRODUCTION

1st 24 hrs. Nat. -----
1st 24 hrs. after shot -----
Gas ----- Cu. Ft.
Dry Hole -----
Abandoned -----

Date

NOV 16 1927

CHAS. L. SHERWOOD

21 **KANSAS** Map No. Sec. 25 Twp. 22 R. 12^E

Well No. 3 Demler
Empire Oil & Refg Co Company

Contractor

SECTION PLAT

605 Ft. from N. Line

Ft. from S. Line

114 Ft. from E. Line

Ft. from W. Line

FIRST REPORTS

Location _____
Rig up _____
Drilling and Remarks: _____

RECORD

Cased _____ in., _____ ft.
Sand _____
Gas _____
Oil _____
Total Depth _____

PRODUCTION

1st 24 hrs. Nat. _____
1st 24 hrs. after shot _____
Gas _____ Cu. Ft.
Dry Hole _____
Abandoned _____

Date

OCT 26 1927

192

CHAS. L. SHERWOOD

Scout