


Map No. _____ Sec. 25 Twp. 22 R. 12

Well No. 4 - Semler Farm _____
Empire Oil Co. Company

NORTH

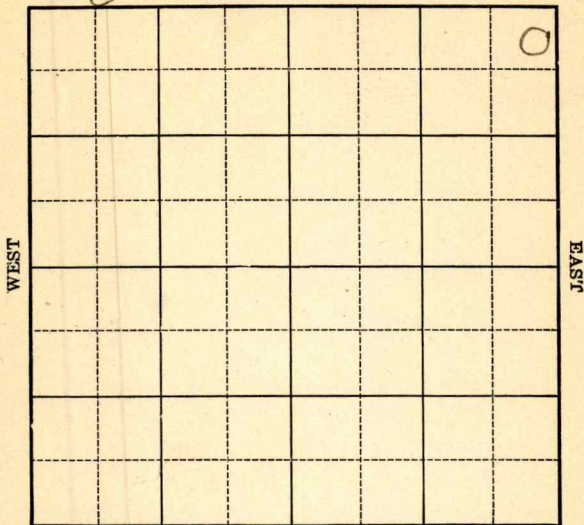

SOUTH

Location _____

Drilling Remarks _____

Rig Up _____

Drilling Remarks _____

RECORD

Cased _____ in. _____ ft.

Sand _____

Gas _____

Oil _____

Total Depth _____

PRODUCTION

1st 24 hrs. Nat. _____

1st 24 hrs. after shot _____

Gas _____ cu. ft.

Dry Hole _____

Abandoned _____

21 **KANSAS** Sec. 25 Twp. 22 R. 12

Well No. 4 *Denber*

Empire Oil & Refg Co Company

Contractor

COMPLETED

SECTION PLAT

220 Ft. from N. Line

Ft. from S. Line

114 Ft. from E. Line

Ft. from W. Line

			o

Location *Broken*

Rig up

Drilling and Remarks:

299 50 lbs.

RECORD

Cased *1684* in., ft.

Sand *1740*

Gas

Oil

Total Depth *1740*

PRODUCTION

1st 24 hrs. Nat.

1st 24 hrs. after shot

Gas Cu. Ft.

Dry Hole

Abandoned

Date

NOV 13 1927

CHAS. L. SHERWOOD

192

Scout

Greenwood E

21 **KANSAS** Map No. Sec. *25* Twp. *22* R. *12*

Well No. *4* *Dumbler* Company *Empire Oil & Ledge Co*


Contractor

SECTION PLAT

230 Ft. from N. Line
Ft. from S. Line
114 Ft. from E. Line
Ft. from W. Line

FIRST REPORTS

Location *Blog Rig*
Rig up
Drilling and Remarks:

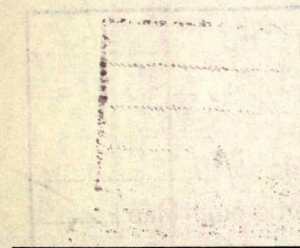

RECORD

Cased _____ in., _____ ft.
Sand _____
Gas _____
Oil _____
Total Depth _____

PRODUCTION

1st 24 hrs. Nat. _____
1st 24 hrs. after shot _____
Gas _____ Cu. Ft.
Dry Hole _____
Abandoned _____

Date

OCT 28 1927

CHAS. L. SHERWOOD

Scout