

Map No. _____ Sec. 25 Twp. 22 R. 11
Well No. 1 Frankenhouser Farm
Lexas Co. Company

NORTH

WEST

EAST

SOUTH

Location _____

Drilling Remarks:

Rig up _____

Drilling Remarks:

RECORD

Cased _____ in. _____ ft.

Sand _____

Gas _____

Oil _____

Total Depth_____

PRODUCTION

1st 24 hrs Nat. _____

1st 24 hrs. after shot_____

Gas _____ cu. ft.

Dry Hole_____

Abandoned _____

Map No. _____ Sec. 25 Twp. 22 R. 11


Well No. 1 Frankenhousen Farm
Texas Co. Company

200 Ft. from N, Line

_____ Ft. from S. Line

Ft. from E. Line

200 Ft. from W. Line

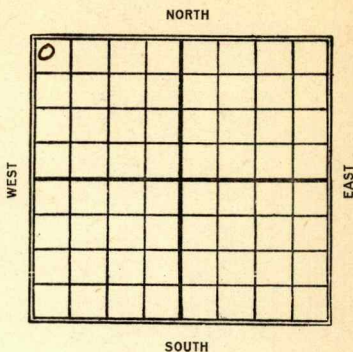

Date 1923

REPORT

3/2	Big.
6/10	D & A. 2200'

Map No. ~~KANSAS~~ 21 Sec. 25 Twp. 22 R. 11

Well No. 1 Frankm house

Texas Co Company

Contractor

ABANDONED SECTION PLAT

200 Ft. from N. Line

Ft. from S. Line

Ft. from E. Line

200 Ft. from W. Line

0			

Location

Rig up

Drilling and Remarks:

Sept 11 1923

LQ+9

2200'

RECORD

Cased _____ in., _____ ft.

Sand _____

Gas _____

Oil _____

Total Depth _____

PRODUCTION

1st 24 hrs. Nat. _____

1st 24 hrs. after shot _____

Gas _____ Cu. Ft.

Dry Hole _____

Abandoned _____

Date

JUN 10 1923

192

M. A. BENEAR

Scout

Map No. **KANSAS** ²¹ Sec. **25** Twp. **22** R. **11**Well No. **1** *Franklin**J. J. Co* Company

Contractor

FIRST REPORT

260 Ft. from N. Line

Ft. from S. Line

Ft. from E. Line

200 Ft. from W. Line

SECTION PLAT

0			

Location

Rig up

Drilling and Remarks:

RECORD

Cased _____ in., _____ ft.

Sand _____

Gas _____

Oil _____

Total Depth _____

PRODUCTION

1st 24 hrs. Nat. _____

1st 24 hrs. after shot _____

Gas _____ Cu. Ft.

Dry Hole _____

Abandoned _____

Date

MAR 2 1923

M. A. BENEAR

191

Scout