


Map No. Greenwood **KANSAS** Sec. 25 Twp. 22 R. 11E ✓
 Well No. 1-2 Sterling Farm
Patterson et al Company

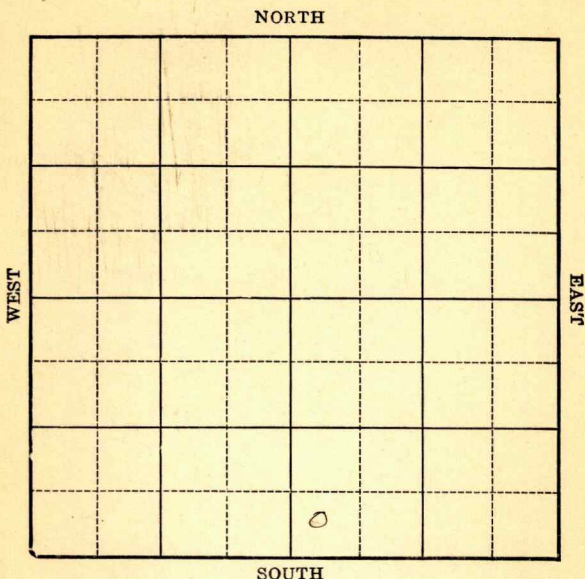

Location _____

Drilling Remarks _____

Rig Up _____

Drilling Remarks _____

RECORD

Cased _____ in. _____ ft.

Sand _____

Gas _____

Oil _____

Total Depth _____

PRODUCTION

1st 24 hrs. Nat. _____

1st 24 hrs. after shot _____

Gas _____ cu. ft.

Dry Hole _____

Abandoned _____

Map No. **KANSAS** Sec. 25 Twp. 22 R. 11^E
Well No. 1- Sterling Farm
Patterson et al Company

NORTH

WEST

EAST

SOUTH

_____ Ft. from N. Line

330 Ft. from S. Line

_____ Ft. from E. Line

330 Ft. from W. Line

1930

Date

REPORT

11/5	Rig
11/12	Dry 415'
11/19	" 1358'
11/26	" 1655'
12/3	" 1950' No sand
12/10	No sand
	Top line 1982
	HFW 2080-90
	T.D. 2090
	Dry & Abandon

Greenwood

E

KANSAS

Map No. _____ Sec. 25 Twp. 22 R. 11

Well No. 1 Sterling

Patterson et al Company

Contractor

FIRST REPORTS

SECTION PLAT

_____ Ft. from N. Line

330 _____ Ft. from S. Line

_____ Ft. from E. Line

330 _____ Ft. from W. Line

		0	

Location _____

Rig up ☒

Drilling and Remarks:

RECORD

Cased _____ in., _____ ft.

Sand _____

Gas _____

Oil _____

Total Depth _____

PRODUCTION

1st 24 hrs. Nat. _____

1st 24 hrs. after shot _____

Gas _____ Cu. Ft.

Dry Hole _____

Abandoned _____

Date

NOV 5

1930

CHAS. L. SHERWOOD

192

Scout

21 **KANSAS** Map No. Sec. 25 Twp. 22 R. 11 E

Well No. 1 Sterling

Patterson Company

Contractor

COMPLETE

SECTION PLAT

.....Ft. from N. Line

330Ft. from S. Line

.....Ft. from E. Line

330Ft. from W. Line

ABANDONED

Location.....

Rig up.....

Drilling and Remarks:

No Sand.

Tap Line 1982

How 2080-90

RECORD

Cased.....in.,ft.

Sand.....

Gas.....

Oil.....

Total Depth 2090

PRODUCTION

1st 24 hrs. Nat.....

1st 24 hrs. after shot.....

Gas.....Cu. Ft.

Dry Hole. ✓

Abandoned. ✓

Date

DEC 10 1930

192

CHAS. L. SHERWOOD

Scout

The show in section
25-22-11E
Please check
Sam

Sam

Should be Range 11.

warning chas.

map

Returned	
Cards	
Tracing	
France Map	
Scarborough Map	
Moody Map	
Scarborough Plat Book	
Moody Plat Book	