

KANSAS

Greenwood

Section 25 Township 22 Range 12E

Well No. 5 Neuenschwander (*Neuenschwander*)

Company ~~Ellis & White~~ Romery & Thompson

Misc.

NORTH

WEST

EAST

	0						

SOUTH

12

KANSAS

Greenwood

Sec. 25 Twp. 22 R. 12E

Well No. #5 Neuenschwander Farm

Barnery + Thompson
Ellis & White Company

Miscellaneous

NORTH

330' Ft. from N. Line


Ft. from S. Line

Ft. from E. Line

990' Ft. from W. Line

NE NW SW

WEST

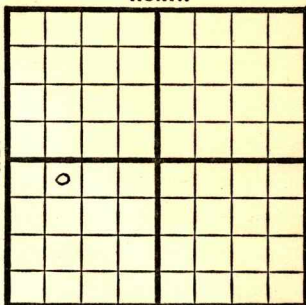

SOUTH

1948

REPORT

9/15 Drlg. 1600'

9/21 6" @ 1606'

9/29 **Bart 1606'**

TD 1606'

6" @ 1606' fsg pipe

10/6 "

10/13 "

10/19 "

10/27 TD 1606'

Bart 1606'

Aband.

ABANDONED

Map No. 2/ Sec. 25 Twp. 22 R. 12E

Well No. 5 Neuenschwander

Romery & Thompson Company

ABANDONED Contractor

NE NW SW

SECTION PLAT

330 Ft. from N. Line

 Ft. from S. Line

 Ft. from E. Line

990 Ft. from W. Line

Greenwood County

Location

Rig up

Drilling and Remarks:

Bar 71606

RECORD

Cased in., ft.

Sand

Gas

Oil

Total Depth 1606

PRODUCTION

1st 24 hrs. Nat.

1st 24 hrs. after shot

Gas Cu. Ft.

Dry Hole

Abandoned

Date

OCT 27 1948

19

S. J. LEWIS

Scout

Greenwood County Kansas State

Map No. _____ Sec. 25 Twp. 22 R. 12E

Well No. 5 Neuenschwander

Ellis & White Company

FIRST REPORT Contractor

NE NW SW

SECTION PLAT

330 Ft. from N. Line


_____ Ft. from S. Line

_____ Ft. from E. Line

990 Ft. from W. Line

Miscellaneous
Remarks:

drlg. 1600

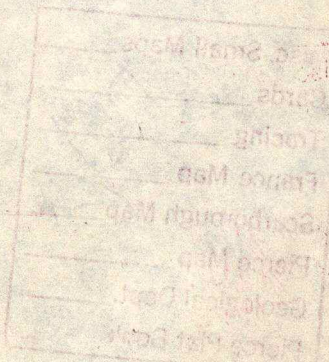

Date
SEP 15 1948

Scout S. J. LEWIS

Greenwood County Kansas StateMap No. 21 Sec. 25 Twp. 22 R. 12EWell No. 5 NeuenschwanderRomery & Thompson CompanyCORRECTION

Contractor

NE NW SW

SECTION PLAT

330 Ft. from N. Line Ft. from S. Line Ft. from E. Line990 Ft. from W. Line

Miscellaneous

Remarks:

Reported Ellis & White

Date

OCT 6 1948

Scout S. J. LEWIS