

Greenwood

FORM 51 5M 6-46 PETROL


KANSAS



Section 25 Township 22 Range 12E

Well No. 3 Neuenschwander (Neunschwander)

Company Romer et al

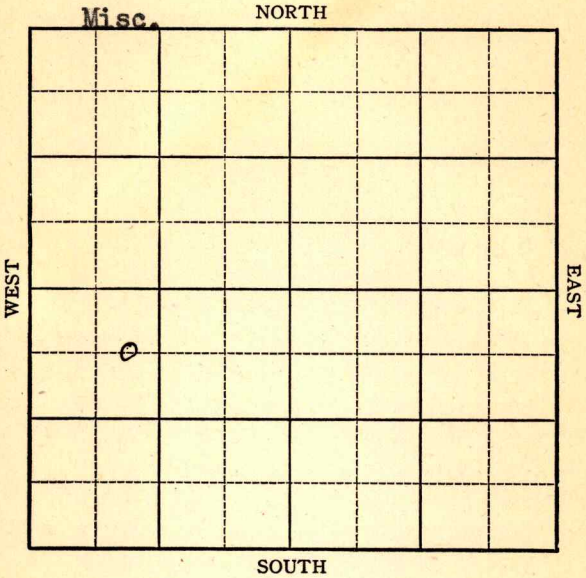

KANSAS

Greenwood county ✓

25

22

12E

Sec. _____ Twp. _____ R. _____

Well No. 3 Neuenschwander Farm _____

Romer et al.

Company _____

Miscellaneous


660 Ft. from N. Line

_____ Ft. from S. Line

_____ Ft. from E. Line

990 Ft. from W. Line

C E L NW SW

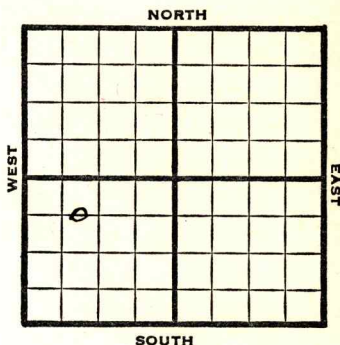

1947

REPORT

5/7 Machine

5/13 Spud

5/20 SD

5/27 12" @ 685'
10" @ 930'
8" @ 1410
Drlg 1525'

6/3 Bart. 1600
6" @ 1605
TD 1693'
809 to 1660-93 CO

6.10 SD

6/18 **Bart 1600'**
6" @ 1605'
80 Qts.
Pump 10 Pot
38.4 Gr.
TD 1693'

COMPLETED

Map No. K21 Sec. 25 Twp. 22 R. 12E

Well No. 3 Neuenschwander


 Romer etal. Company

 FIRST REPORT Contractor

C E L NW SW

SECTION PLAT

 660 Ft. from N. Line
 Ft. from S. Line
 Ft. from E. Line
 990 Ft. from W. Line

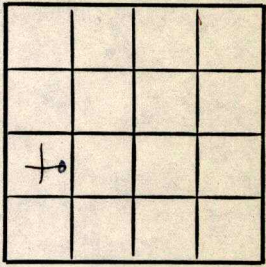

Greenwood County

Location

Rig up

Drilling and Remarks:

Machine

RECORD

Cased in., ft.
Sand
Gas
Oil
Total Depth

PRODUCTION

1st 24 hrs. Nat.
1st 24 hrs. after shot
Gas Cu. Ft.
Dry Hole
Abandoned

Date

 MAY 7 1947 19 S. J. LEWIS Scout

Map No. 21 Sec. 25 Twp. 22 R. 12E

Well No. 3 Neuenschwander

Romer et al. Company

COMPLETE Contractor

C E L NW SW

SECTION PLAT

660 Ft. from N. Line

 Ft. from S. Line

 Ft. from E. Line

990 Ft. from W. Line

0			

Greenwood County

Location

Rig up

Drilling and Remarks:

Bar 1600

6" C 1605

80 gals.

Run 10 1/2

38 1/2

RECORD

Cased in., ft.

Sand

Gas

Oil

Total Depth 1688

PRODUCTION

1st 24 hrs. Nat.

1st 24 hrs. after shot

Gas Cu. Ft.

Dry Hole

Abandoned

Date

JUN 1 8 1947

19

S. J. LEWIS Scout