

Section 25 Township 22 Range 12E

~~#1~~
#6

Well No. Neuenschwander

Company C. Thompson (*Neuenschwander*)

NORTH

11

WEST

EAST

SOUTH

Greenwood

25

22

12E

Sec. _____ Twp. _____ R. _____

#6
#1

Neuenschwander

Well No. _____ Farm _____

C. Thompson

Company

White & Ellis

Contractor

340

Ft. from N. Line


Ft. from S. Line

340

Ft. from E. Line

Ft. from W. Line

NE NE SW TWIN

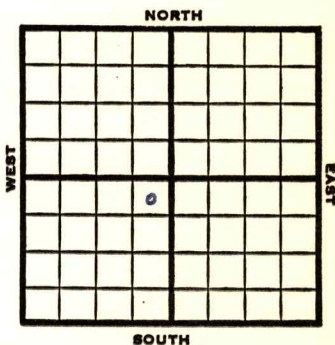

REPORT

1953

1/28

RUR

4/22

Spud 1-23-53

Oil Well

TD 1705

8" @ 90

KC 1130, Bart 1628,

TD 1705

5" @ 1628

CO to 1705

115 qt/

Comp. 25 bopd 10 bw

COMPLETED

Kansas

Map No. _____ Sec. 25 Twp. 22 R. 12E

Well No. 6 Neuenschwander

C. Thompson Company

CORRECTION Contractor

NE NE SW

SECTION PLAT

340 Ft. from N. Line

_____ Ft. from S. Line

340 Ft. from E. Line

_____ Ft. from W. Line

	o		

Greenwood County

Location _____

Rig up _____

Drilling and Remarks:

Reported
#1

RECORD

Cased _____ in., _____ ft.

Sand _____

Gas _____

Oil _____

Total Depth _____

PRODUCTION

1st 24 hrs. Nat. _____

1st 24 hrs. after shot _____

Gas _____ Cu. Ft.

Dry Hole _____

Abandoned _____

Date

MAR 11 1950 19

J. G. McGEHEE Sec

