


Section 25 Township 22 Range 12E
Well No. 8 Neuanschwander (*Neunschwander*)
Company Romary & Thomson

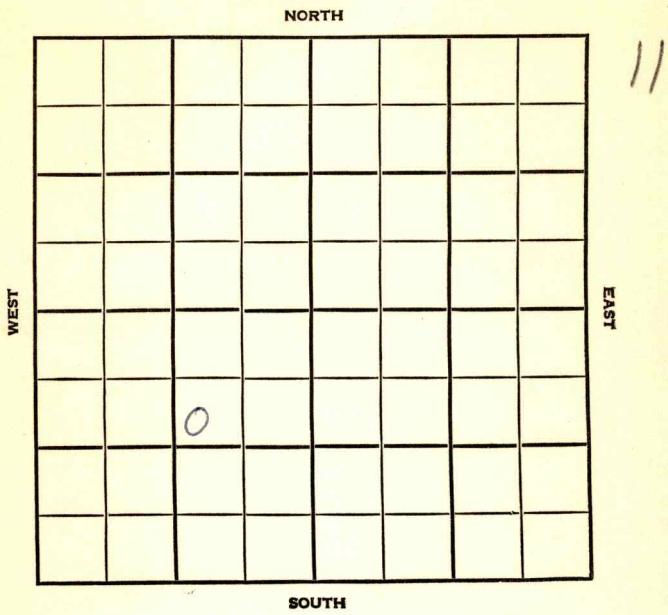

Greenwood

KANSAS

SEC.	TWP.	R.
25	22	12E
WELL NO.		

#8 Neuanschwander

FARM

COMPANY

Romary & Thomson

CONTRACTOR

Brown

Lamont


_____ Ft. from N. Line

_____ Ft. from S. Line

_____ Ft. from E. Line

_____ Ft. from W. Line

SW NE SW

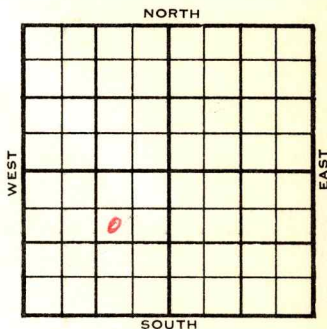

L955

ELEVATION

REPORT

7/20

Comm 7-11-55

10" @695 Drlg 835

3/3

7" @1440 TD 1695' D&A

L.Bart. 1613,

ABANDONED

Date Comm. 7-11-55

10" @ 695 drlg. 835

County Greenwood Elev. _____
 Sec. 25 Twp. 22 Rge. 12E
 Company Romary & Thomson
 Farm Name Neuanschwander No. 8

TOPS	DEPTH	LOG	DATUM	Loc. in Sec.
Anh.				SW NE SW
Tp.				
H.				
Tr.				
Dg.				
Bl.				
L. <u>Bark</u>	<u>1613</u>			Geol. _____
K.C.				Contr. _____
B.K.C.				<u>Brown</u>
Ce.				Pool _____
C.				<u>Lamont</u>
M.				
M.				
K.				
Mz.				
Mq.				
V.				
S.				
S.				
A.				
R.				
Pe.				
G.				
TD.	<u>1695</u>			

ABANDONED

Date Comm. 7-11-55 AUG 3 1955
10" @ 695 8 5/8" @ 960 7" @ 1440
TD 1695

D & A