

KANSAS


Harvey

FORM 51 IOM 12-46 PETROL

Section 26 Township 22 Range 2E

Well No. 1 Kirkpatrick

Company J. E. Palenski

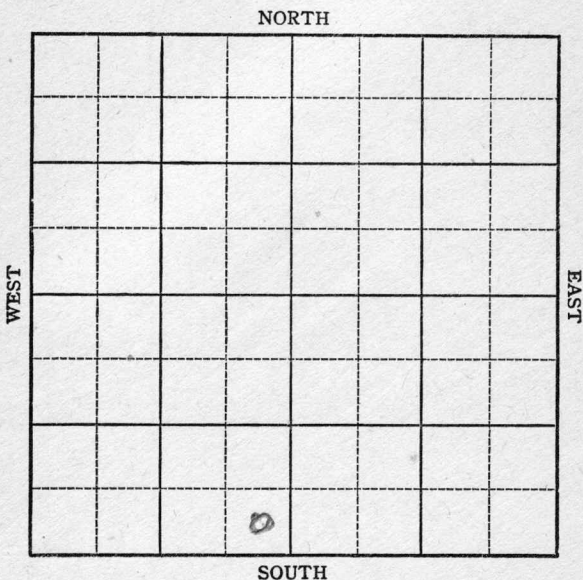

26 KANSAS 22

Harvey county ✓
2E

Sec. _____ Twp. _____ R. _____

Well No. 1 Kirkpatrick Farm _____

J. E. Palenski Company _____

Wildcat

_____ Ft. from N. Line

330


_____ Ft. from S. Line

330

_____ Ft. from E. Line

_____ Ft. from W. Line

SE SW

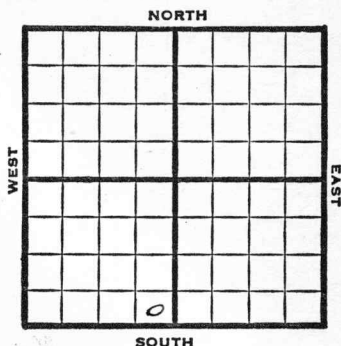

1947 Elev. 1501' REPORT

5/28 15" @ 150
1200 SD

6/3 Run 12"

6/10 SD

6/17 "

6/24 "

7/1 "

7/8 12" @ 263'
10" @ 1200'
Drlg. 1325'

7/16 1630' run 10"

7/22 10" @ 1624
TD 1628

7/29 Drlg. 2075'

8/6 Lansing 2185'
TD 2460'
5" @ 2460'
RUST

OVER

1947

8/13 Pipe Collapsed

8/20 " "

8/27 " "

9/3 " "

9/10 Drlg. 2550'

9/17 TD 2550'

9/24 "

10/1 "

10/8 "

10/15 "

10/22 TD 2625

10/29 Drlg. 2650'

11/5 "

11/12 371' of 4" Liner @ 2745'
Drlg. 2803'

11/19 93' of 3" liner @ 2816-2820

11/25 TD 2850' SG

12/3 "

12/10 "

12/17 "

12/30 87' of 3" liner @ 2823'

1948

1/7 "

1/14 Lans. 2443'
TD 2855'
Abd.

ABANDONED

Map No. _____ Sec. 26 Twp. 22 R. 2E

Well No. 1 Kirkpatrick

J. E. Palenski Company

FIRST REPORT

Contractor

SE SW


SECTION PLAT

_____ Ft. from N. Line

330 Ft. from S. Line

330 Ft. from E. Line

_____ Ft. from W. Line

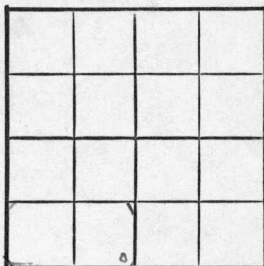

Harvey County

Location _____

Rig up _____

Drilling and Remarks:

15" @ 150

1200 SD

RECORD

Cased _____ in., _____ ft.

Sand _____

Gas _____

Oil _____

Total Depth _____

PRODUCTION

1st 24 hrs. Nat. _____

1st 24 hrs. after shot _____

Gas _____ Cu. Ft.

Dry Hole _____


Abandoned _____

Date

MAY 28 1947 19 S. J. LEWIS Scout

Map No. _____
Well No. _____
Company _____
Contractor _____

SECTION PLAT

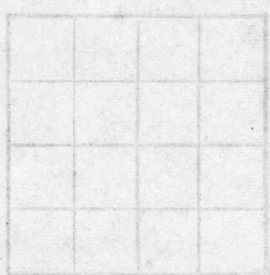

ft. from N. Line _____
ft. from E. Line _____
ft. from E. Line _____
ft. from W. Line _____

RECORD

Cased _____
Sand _____
Gas _____

Location _____
Rig up _____
Drilling and Remarks _____

- Misc. Small Maps _____
- Cards _____
- Tracing _____
- France Map _____
- Scarborough Map _____
- Pierce Map _____
- Geological Dept. _____
- Pierce Plat Book _____

Date _____

Map No. 24 Sec. 26 Twp. 22 R. 2E

Well No. 1 Kirkpatrick

J. E. Palenski Company

ABANDONED Contractor

SE SW


E. 1501
SECTION PLAT

 Ft. from N. Line

330 Ft. from S. Line

330 Ft. from E. Line

 Ft. from W. Line

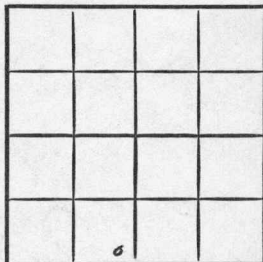

Harvey County

Location

Rig up

Drilling and Remarks:

Wanz 2448

RECORD

Cased in., ft.

Sand

Gas

Oil

Total Depth 2855

PRODUCTION

1st 24 hrs. Nat.

1st 24 hrs. after shot

Gas Cu. Ft.

Dry Hole

Abandoned

Date

JAN 14 1948 19

S. J. LEWIS Scout


2

[Signature]

K #

ap

ap *[Signature]*

✓

t.

ak

...k