


Map No. **KANSAS** Sec. 26 Twp. 22 R. 9  
 Well No. 1 Chas Leedy Farm  
Leedy O + H Company

NORTH

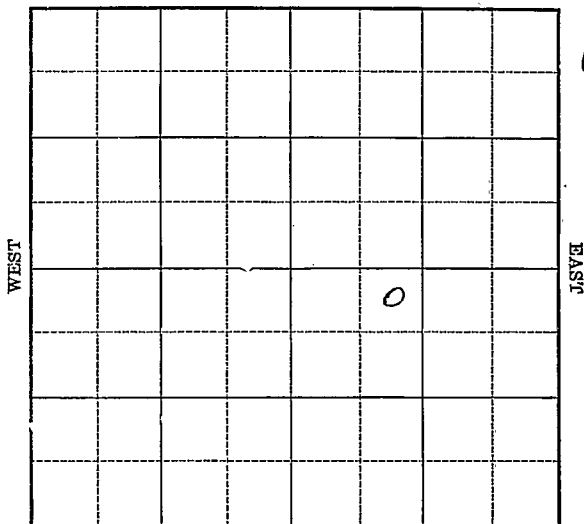

SOUTH

Location \_\_\_\_\_

Drilling Remarks

Rig Up \_\_\_\_\_

Drilling Remarks

RECORD

Cased \_\_\_\_\_ in. \_\_\_\_\_ ft.

Sand \_\_\_\_\_

Gas \_\_\_\_\_

Oil \_\_\_\_\_

Total Depth \_\_\_\_\_

PRODUCTION

1st 24 hrs. Nat. \_\_\_\_\_

1st 24 hrs. after shot \_\_\_\_\_

Gas \_\_\_\_\_ cu. ft.

Dry Hole \_\_\_\_\_

Abandoned \_\_\_\_\_

Chase Co

Map No. Kansas Sec. 26 Twp. 22 R. 9Well No. 1 Chas A. Leedy FarmSelby O. & G. Company

NORTH


330 Ft. from N. Line

Ft. from S. Line

Ft. from E. Line

990 Ft. from W. Line

WEST

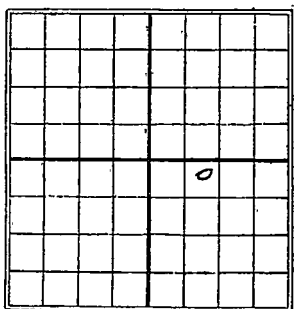

EAST

SOUTH

Date

1926

REPORT

1/14

Location

1/20

Timbers

1/27

Conjectured Loc. only

2/3

Abandoned Location

Chase Co  
 22 KANSAS Sec. 26 Twp. 22 R. 9  
 Well No. 1 Chas. L. Sherwood  
 Kelly Oil & Gas Co Company

Contractor

## FIRST REPORTS

330 Ft. from N. Line

Ft. from S. Line

Ft. from E. Line

990 Ft. from W. Line

## SECTION PLAT

|  |  |   |  |
|--|--|---|--|
|  |  |   |  |
|  |  |   |  |
|  |  | o |  |
|  |  |   |  |

Location ✓

Rig up

Drilling and Remarks:

## RECORD

Cased \_\_\_\_\_ in., \_\_\_\_\_ ft.

Sand \_\_\_\_\_

Gas \_\_\_\_\_

Oil \_\_\_\_\_

Total Depth \_\_\_\_\_

## PRODUCTION

1st 24 hrs. Nat. \_\_\_\_\_

1st 24 hrs. after shot \_\_\_\_\_

Gas \_\_\_\_\_ Cu. Ft.

Dry Hole \_\_\_\_\_

Abandoned \_\_\_\_\_

Date

JAN 14 1926 CHAS. L. SHERWOOD  
 192 Scout

22 KANSAS 26 Twp. 22 R. 9  
 Map No. Sec. 26  
 Well No. 1 Chas. L. Sherwood  
 Lehigh Oil & Gas Co. Company

Contractor

COMPLETED

SECTION PLAT

330

Ft. from N. Line

Ft. from S. Line

Ft. from E. Line

990

Ft. from W. Line

ABANDONED

|  |  |  |  |
|--|--|--|--|
|  |  |  |  |
|  |  |  |  |
|  |  |  |  |
|  |  |  |  |

Location

Rig up

Drilling and Remarks:

## RECORD

Cased in, ft.

Sand

Gas

Oil

Total Depth

## PRODUCTION

1st 24 hrs. Nat.

1st 24 hrs. after shot

Gas Cu. Ft.

Dry Hole

Abandoned

Date

FEB 3 1926

192

CHAS. L. SHERWOOD

Scout

Location

Chas. L.