


Map No. KANSAS Sec. 26 Twp. 22 R. 10^E

Well No. 1-Andrews Farm

J. E. Leadbetter Company

NORTH Aladdin Pet

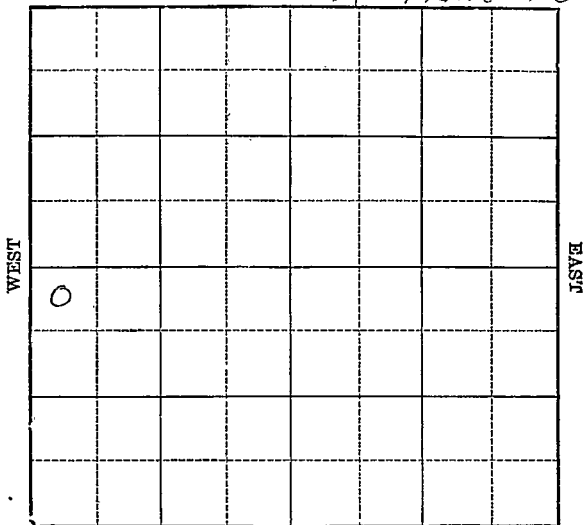

Location _____

Drilling Remarks _____

Rig Up _____

Drilling Remarks _____

RECORD

Cased _____ in. _____ ft.

Sand _____

Gas _____

Oil _____

Total Depth _____

PRODUCTION

1st 24 hrs. Nat. _____

1st 24 hrs. after shot _____

Gas _____ cu. ft.

Dry Hole _____

Abandoned _____

Map No. KANSAS Sec. 26 Twp. 22 R. 10^E

Well No. 1- Andrews Farm

J. E. Leach Company

Aladdin PET CO. NORTH


330 Ft. from N. Line

2 Ft. from S. Line

330 Ft. from E. Line

330 Ft. from W. Line

1930

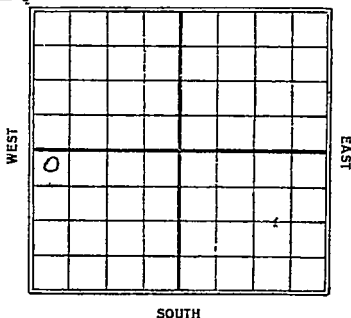

Date

REPORT

6/11	Loc
6/18	—
6/25	—
7/2	—
7/9	—
7/16	—
7/23	—
7/30	—
8/6	—
8/13	—
8/20	—
8/27	Spdg.
9/3	Spdg + S.D.
9/10	Only 300'
9/17	" 900'
9/24	" 910'
10/1	" 1360'
10/8	Sty 8" 1820'
10/15	Top line 2300
	HFW 2340'
	TD 2340
	Dry & Abandon

Greenwood

21 KANSAS

Map No. _____ Sec. 26 Twp. 22 R. 10^E

Well No. 1 Andrews

J. E. Leader

Company

Contractor

FIRST REPORTS

330. Ft. from N. Line

_____ Ft. from S. Line

_____ Ft. from E. Line

330 Ft. from W. Line

SECTION PLAT

0			

Location ✓

Rig up

Drilling and Remarks:

RECORD

Cased _____ in., _____ ft.

Sand _____

Gas _____

Oil _____

Total Depth _____

PRODUCTION

1st 24 hrs. Nat. _____

1st 24 hrs. after shot _____

Gas _____ Cu. Ft.

Dry Hole _____

Abandoned _____

Date

JUN 11 1930

19 CHAS. L. SHERWOOD

Scout

21 **KANSAS** *Greenwood*Map No. _____ Sec. *26* Twp. *22* R. *10* *E*Well No. *1* *Andrews**Aladdin Pet Co*

Company

Contractor

CORRECTION*330* Ft. from N. Line

_____ Ft. from S. Line

_____ Ft. from E. Line

330 Ft. from W. Line**SECTION PLAT**

<i>0</i>			

Location _____

Rig up _____

Drilling and Remarks:

*Chg Ownership***RECORD**

Cased _____ in., _____ ft.

Sand _____

Gas _____

Oil _____

Total Depth _____

PRODUCTION

1st 24 hrs. Nat. _____

1st 24 hrs. after shot _____

Gas _____ Cu. Ft.

Dry Hole _____

Abandoned _____

Date

AUG 27 1930

19

CHAS. L. SHERWOOD

Scout

*Greenwood*21
Map No. **KANSAS** Sec. *26* Twp. *22* R. *10*Well No. *1* *Andrews**Claddin But Co* Company

Contractor

COMPLETE**SECTION PLAT***330* Ft. from N. Line

_____ Ft. from S. Line

_____ Ft. from E. Line

330 Ft. from W. Line

<i>0</i>			

ABANDONED

Location _____

RECORD

Cased _____ in., _____ ft.

Sand _____

Gas _____

Oil _____

Total Depth *2340***PRODUCTION**

1st 24 hrs. Nat. _____

1st 24 hrs. after shot _____

Gas _____ Cu. Ft.

Dry Hole ☒Abandoned ☒

Date

OCT 15 1930

19

CHAS. L. SHERWOOD

Scout