



WELL RECORD

~~Mail to Cooperation Commission, Oklahoma City, Oklahoma~~

Company T. K. Simmons Address 810 Mid-Continent Bldg., Tulsa, Okla.

Greenwood P.D. Fankhauser
County Farm Sec. 26 Twp. 22 Rge. 12 Well No. 1

Drilling Commenced 4-11, 1928 Drilling Completed 5-7 ~~4-29~~, 1928

Correspondence regarding this well should be sent to Name _____ Add. _____

CASING RECORD

SIZE	Put in Well		Pulled Out		Left in Well		PACKERS and SHOES
	Ft.	In.	Ft.	In.	Ft.	In.	
12-1/2"	657	5	657	5			
10"	955	1	955	1			
8-1/4"	1319	3	1319	3			
6-5/8"	1732	1	1732	1			
15-1/2"	46		46				

Character of well dry hole

Oil well, initial production _____

Gas well, rock pressure _____ Volume _____ Wet or Dry _____


Elevation above sea level at top of casing _____

Location of well in section: NE Corner of SW 1/4 General Remarks: _____

26-22-12 Contractor - Patton Drilling Company

Spot Well Correctly

640 Acres

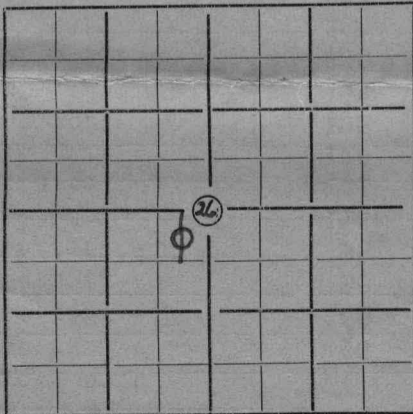

FORMATION RECORD

Corporation Commission
Form 1002 Rev'd to 6-19
Olds Press, Tulsa, Okla.

Show all Formation, especially all sands and character and contents thereof.

FORMATION	Top	Bottom	REMARKS
Gravel brown soft		46	Set 15-1/2" pipe at 46 feet
Lime white hard	46	60	
Slate blue soft	60	80	
Lime white hard	80	90	
Slate blue soft	90	115	
Lime white hard	115	125	
Slate white soft	125	170	
Lime white hard	170	185	
Slate gray soft	185	195	
Lime white hard	195	200	
Slate white soft	200	260	
Lime white hard	260	270	
Slate white soft	270	290	
Lime white hard	290	325	
Slate blue soft	325	345	
Lime white hard	345	355	
Slate white soft	355	370	
Lime white hard	370	375	
Slate white soft	375	530	
Lime white hard	530	535	
Sand white soft	535	555	Hole full water
Sandy lime white hard	535	595	
Slate blue soft	595	615	
Sandy slate light soft	615	630	
Sand light soft	630	645	
Lime white hard	645	830	Set 12-1/2" Casing at 656
Slate blue soft	830	835	
Lime white hard	835	845	
Slate blue soft	845	850	
Lime white hard	850	880	Hole full water at 880
Sand white soft	880	895	
Lime white hard	895	910	
Slate blue soft	910	930	
Lime white hard	930	935	
Slate blue soft	935	950	
Lime white soft	950	1010	Set 10" Casing at 958
Slate blue soft	1010	1020	
Lime white hard	1020	1030	
Sandy lime white soft	1030	1040	2-Bailers water per hour
Lime white hard	1040	1070	
Slate blue soft	1070	1220	
Lime white hard	1220	1240	
Slate white soft	1240	1320	
Lime white hard	1320	1330	Set 8-1/4" Casing at 1319
Slate blue soft	1330	1345	
Lime white hard	1345	1350	
Slate white soft	1350	1585	
Slate light soft	1585	1600	
Slate black soft	1600	1660	
Slate light soft	1660	1730	
Sand light soft	1730	1740	Set 6-5/8" Casing at 1730
Lime white hard	1740	1787	
Sand white soft	1787	1788	Total Depth Hole full water

Method of shutting off water..... Is water completely shut off?.....

Amount of water with oil..... per cent. Is oil out?.....

I, T. K. Simmons being first duly sworn on oath, state that I have knowledge of the facts and matters herein set forth and that the same are true and correct.

T. K. Simmons Representative of Company

Subscribed and sworn to before me this 7th day of May, 1928.

My commission expires June 28th, 1931 S. P. Shubau Notary Public

