


Map No. \_\_\_\_\_ Sec. 26 Twp. 22 R. 12

Well No. 2c - Ott Farm \_\_\_\_\_

Empire Oil Refg. Company

NORTH

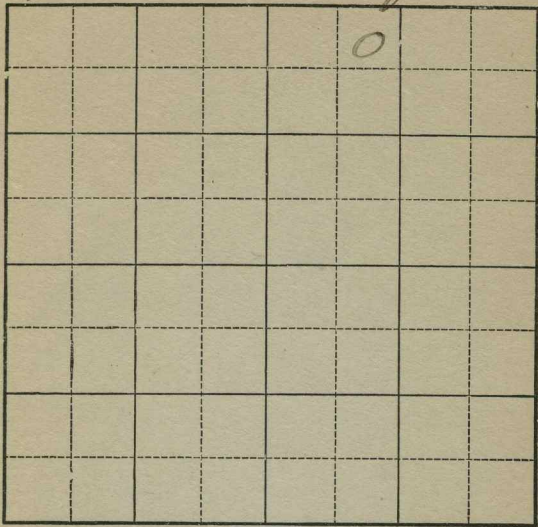

SOUTH

Location \_\_\_\_\_

Drilling Remarks \_\_\_\_\_

Rig Up \_\_\_\_\_

Drilling Remarks \_\_\_\_\_

RECORD

Cased \_\_\_\_\_ in. \_\_\_\_\_ ft.

Sand \_\_\_\_\_

Gas \_\_\_\_\_

Oil \_\_\_\_\_

Total Depth \_\_\_\_\_

PRODUCTION

1st 24 hrs. Nat. \_\_\_\_\_

1st 24 hrs. after shot \_\_\_\_\_

Gas \_\_\_\_\_ cu. ft.

Dry Hole \_\_\_\_\_

Abandoned \_\_\_\_\_

Map No. \_\_\_\_\_ Sec. 26 Twp. 22 R. 12

Well No. 2c - Ott Farm \_\_\_\_\_

Empire Oil Refg. Company


NORTH

330 Ft. from N. Line

\_\_\_\_\_ Ft. from S. Line

\_\_\_\_\_ Ft. from E. Line

990 Ft. from W. Line

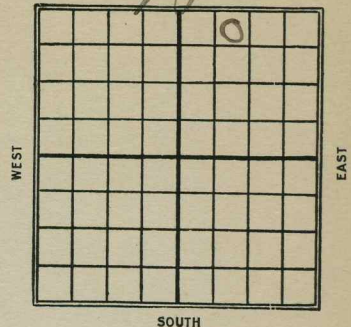

SOUTH

1927

Date

REPORT

12/4 Bldg Rig  
12/11 Rigging up  
12/19 Drlg 725  
1928  
1/5 Drlg 1570  
1/11 1652-1680 T.D. 1696  
 120/50 bbb

21 KANSAS 26 Sec. 22 Twp. 12 R. 12

Well No. 2<sup>c</sup> set

Empire Oil & Refg Co Company

Contractor

FIRST REPORTS

SECTION PLAT

330 Ft. from N. Line
Ft. from S. Line
Ft. from E. Line
990 Ft. from W. Line

Section plat grid with handwritten '0' in the top-right cell.

Location Blog Key
Rig up
Drilling and Remarks:

RECORD
Cased in. ft.
Sand
Gas
Oil
Total Depth

PRODUCTION
1st 24 hrs. Nat.
1st 24 hrs. after shot
Gas Cu. Ft.
Dry Hole
Abandoned

Date DEC 14 1927 CHAS. L. SHERWOOD Scout

21 KANSAS 26 Sec. 22 Twp. 12 R. 12

Well No. 2<sup>c</sup> set

Empire Oil Co Company

Contractor

COMPLETED

SECTION PLAT

330 Ft. from N. Line
Ft. from S. Line
Ft. from E. Line
990 Ft. from W. Line

Section plat grid with handwritten '0' in the top-right cell.

Location
Rig up
Drilling and Remarks:

120/50 lbs

RECORD
Cased in. ft.
Sand 1652-1680
Gas
Oil
Total Depth 1696

PRODUCTION
1st 24 hrs. Nat.
1st 24 hrs. after shot
Gas Cu. Ft.
Dry Hole
Abandoned

Date JAN 11 1928 CHAS. L. SHERWOOD Scout