


Map No. \_\_\_\_\_ Sec. 26 Twp. 22 R. 12  
Well No. 2/BH-C-Ott Farm \_\_\_\_\_  
Empire Oil & Refg Company

NORTH

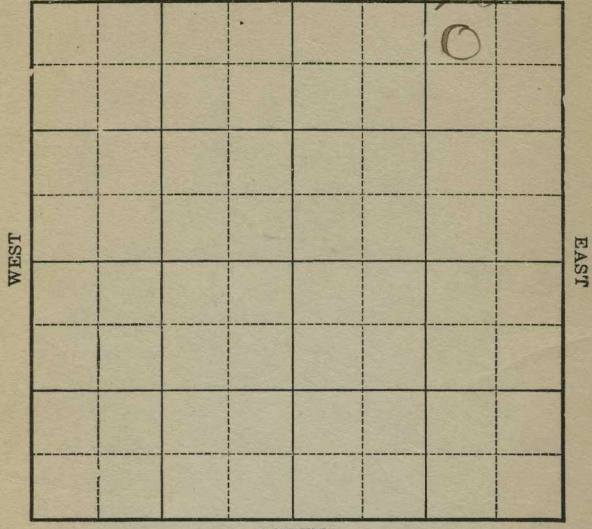

WEST

EAST

SOUTH

Location \_\_\_\_\_  
Drilling Remarks \_\_\_\_\_

Rig Up \_\_\_\_\_  
Drilling Remarks \_\_\_\_\_


RECORD  
Cased \_\_\_\_\_ in. \_\_\_\_\_ ft.  
Sand \_\_\_\_\_  
Gas \_\_\_\_\_  
Oil \_\_\_\_\_  
Total Depth \_\_\_\_\_

PRODUCTION  
1st 24 hrs. Nat. \_\_\_\_\_  
1st 24 hrs. after shot \_\_\_\_\_  
Gas \_\_\_\_\_ cu. ft.  
Dry Hole \_\_\_\_\_  
Abandoned \_\_\_\_\_

Map No. \_\_\_\_\_ Sec. 26 Twp. 22 R. 12  
Well No. 2/BH-C-Ott Farm \_\_\_\_\_  
Empire Oil & Refg Company

NORTH

330 Ft. from N. Line  
\_\_\_\_\_ Ft. from S. Line  
990 Ft. from E. Line  
\_\_\_\_\_ Ft. from W. Line

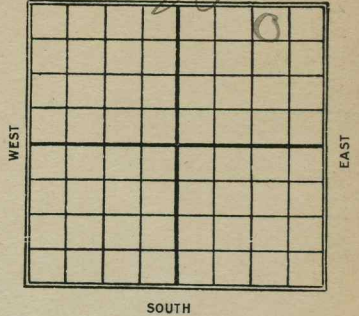

WEST

EAST

SOUTH

1927

Date \_\_\_\_\_ REPORT \_\_\_\_\_

11/16 T.O.G.  
11/23 Bldg.  
11/23 Bldg Rig  
11/30 Spudding  
12/5 Drlg 1025'  
12/14 Met 6" top sand 1649  
Drlg 1671  
12/21 1661-1724 T.D. 1725  
130/135 bbls

*Sherwood*

21 **KANSAS** Sec. 26 Twp. 22 R. 12

Well No. *1" c" ott*

*Empire Oil Co* Company

Contractor

**COMPLETED**

**SECTION PLAT**

*330* Ft. from N. Line

Ft. from S. Line

*990* Ft. from E. Line

Ft. from W. Line

			0

Location

Rig up

Drilling and Remarks:

*1307 135 Bls.*

**RECORD**

Cased *1661-1724* in., ft.

Sand

Gas

Oil

Total Depth *1725*

**PRODUCTION**

1st 24 hrs. Nat.

1st 24 hrs. after shot

Gas \_\_\_\_\_ Cu. Ft.

Dry Hole

Abandoned

Date

**DEC 21 1927**

**CHAS. L. SHERWOOD**

192

Scout

*Sherwood*

21 **KANSAS** Sec. 26 Twp. 22 R. 12

Well No. *1" c" ott*

*Empire Oil Co* Company

Contractor

**CORRECTION**

**SECTION PLAT**

*330* Ft. from N. Line

Ft. from S. Line

*990* Ft. from E. Line

Ft. from W. Line

			0

Location *Blog*

Rig up

Drilling and Remarks:

*Plus reported as 2" B" chy to 1" c"*

**RECORD**

Cased \_\_\_\_\_ in., ft.

Sand

Gas

Oil

Total Depth

**PRODUCTION**

1st 24 hrs. Nat.

1st 24 hrs. after shot

Gas \_\_\_\_\_ Cu. Ft.

Dry Hole

Abandoned

Date

**NOV 23 1927**

**CHAS. L. SHERWOOD**

192

Scout

21 **KANSAS** Greenwood  
Map No. Sec. 26 Twp. 22 R. 12

Well No. 2 B ott  
Empire Oil & Refg Co. Company

Contractor

**FIRST REPORTS**

**SECTION PLAT**

330 Ft. from N. Line  
Ft. from S. Line  
990 Ft. from E. Line  
Ft. from W. Line

			o

Location 104

Rig up

Drilling and Remarks:

**RECORD**

Cased \_\_\_\_\_ in., \_\_\_\_\_ ft.

Sand \_\_\_\_\_

Gas \_\_\_\_\_

Oil \_\_\_\_\_

Total Depth \_\_\_\_\_

**PRODUCTION**

1st 24 hrs. Nat. \_\_\_\_\_

1st 24 hrs. after shot \_\_\_\_\_

Gas \_\_\_\_\_ Cu. Ft.

Dry Hole \_\_\_\_\_

Abandoned \_\_\_\_\_

Date

NOV 16 1927 **CHAS. L. SHERWOOD**  
Scout