


Map No. _____ Sec. 26 Twp. 22 R. 11

Well No. 1 - Oliver Farm _____
Loy & Leader Company _____

NORTH

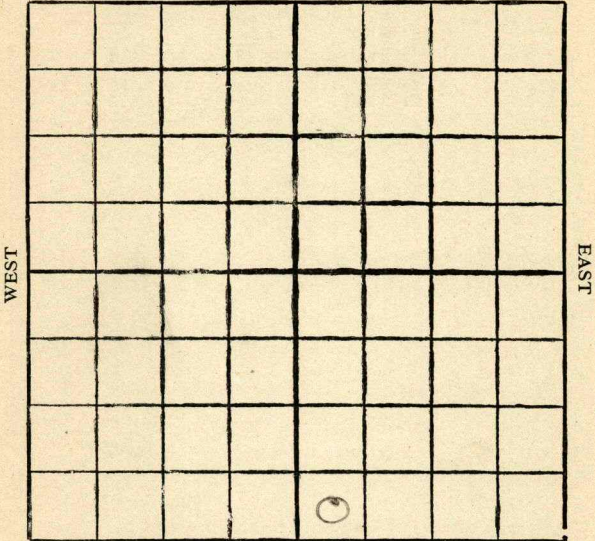

SOUTH

Location _____

Drilling Remarks _____

RECORD

Cased _____ in. _____ ft.

Sand _____

Gas _____

Oil _____

Total Depth _____

Rig Up _____

Drilling Remarks _____

PRODUCTION

1st 24 hrs. Nat. _____

1st 24 hrs. after shot _____

Gas _____ cu. ft.

Dry Hole _____


Abandoned _____

Greenwood

Map No. Kansas Sec. 26 Twp. 22 R. 11

Well No. 1 Oliver Farm
Loyd Leader Company

NORTH

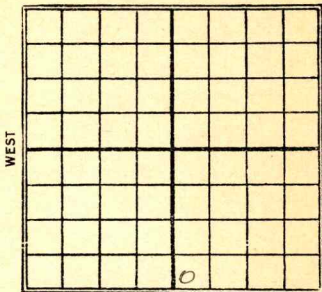

..... Ft. from N. Line

330 Ft. from S. Line

..... Ft. from E. Line

330 Ft. from W. Line

SOUTH

Date

REPORT

1927

4/27 location

5/5 Rig

5/12 Spudding

5/18 Drlg 1040

5/25 Sandy shale 1931-37. Water

Drlg 1962-

6/1 Sdy shale 1931-37

Top line 1979

D * a. 1998 H F W

Sherwood

21 **KANSAS** Sec. 26 Twp. 22 R. 11

Well No. 1 *Oliver*
Lay & Leader Company

Contractor

COMPLETED

SECTION PLAT

----- Ft. from N. Line

330 Ft. from S. Line

----- Ft. from E. Line

330 Ft. from W. Line

ABANDONED

		o	

Location -----

Rig up -----

Drilling and Remarks:

Ady Shale 1931-37

Top lime 1979

SH 1998
AFW

RECORD

Cased ----- in., ----- ft.

Sand -----

Gas -----

Oil -----

Total Depth 1998

PRODUCTION

1st 24 hrs. Nat. -----

1st 24 hrs. after shot -----

Gas ----- Cu. Ft.

Dry Hole

Abandoned

Date

JUN 1 1927

CHAS. L. SHERWOOD

192

Scout

Sherwood

21 **KANSAS** Sec. 26 Twp. 22 R. 11

Well No. 21 *Oliver*

Loy & Leaden Company

Contractor

FIRST REPORTS

SECTION PLAT

----- Ft. from N. Line

330 ----- Ft. from S. Line

----- Ft. from E. Line

330 ----- Ft. from W. Line

Location -----

Rig up -----

Drilling and Remarks:

RECORD

Cased ----- in., ----- ft.

Sand -----

Gas -----

Oil -----

Total Depth -----

PRODUCTION

1st 24 hrs. Nat. -----

1st 24 hrs. after shot -----

Gas ----- Cu. Ft.

Dry Hole -----

Abandoned -----

Date

APR 27 1927

CHAS. L. SHERWOOD

192

Scout