

Kansas 27 T. 22 S., R. 13 E.

Greenwood County

Libman & Braden Company


Koenig #1. Farm

T.D. 8907

10466

Relation by

Drilled 3/1 to 4/4/29.

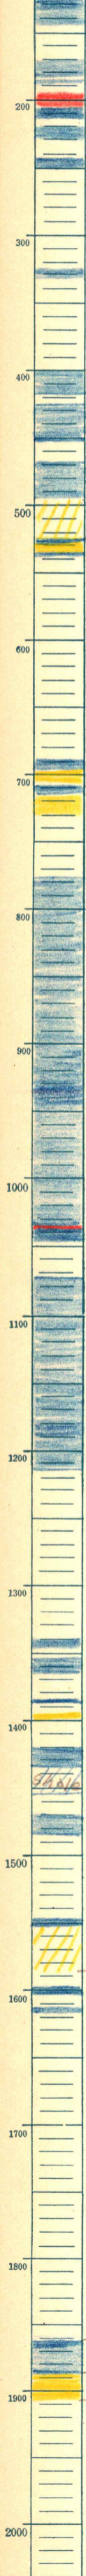

525  
528  
536 2 B.M. Pr. L.

705  
708  
715 H.F.W.

?

44616

B7

1861  
1887  
1907 T.D