

Marion

Form 51-5M-9-28-27423

Map No. **KANSAS** Sec. **27** Twp. **22^S** R. **4E**

Well No. **1 - Ruckle** Farm
Sarter Oil Co. Company

NORTH

WEST	0							4 EAST

SOUTH

Location.....
Drilling Remarks.....
.....
.....
Rig Up.....
Drilling Remarks.....
.....
.....
RECORD

Cased..... in..... ft.
Sand.....
Gas.....
Oil.....
Total Depth.....

PRODUCTION

1st 24 hrs. Nat.....
1st 24 hrs. after shot.....
Gas..... cu. ft.....
Dry Hole.....
Abandoned.....

Map No. Sec. Twp. R.

Well No. Farm


..... Company

..... Ft. from N. Line

..... Ft. from S. Line

..... Ft. from E. Line

..... Ft. from W. Line

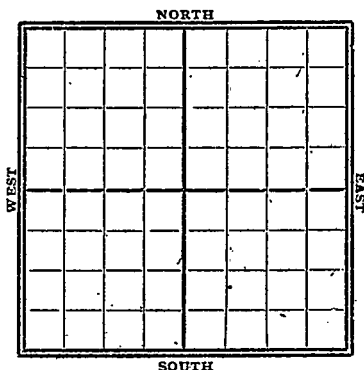

1923

Date

REPORT

Gypsy Records

4/25

Abd T.D. 2705'

K23

MAP NO. KANSAS SEC. 27 TWP. 28S R. 4E

WELL NO. 1 Ruckle

Carter Oil

COMPANY

CONTRACTOR

SECTION PLAT

0			

_____ FT. FROM N. LINE

_____ FT. FROM S. LINE

_____ FT. FROM E. LINE

_____ FT. FROM W. LINE

RECORD

LOCATION _____

CASED _____ IN. _____ FT.

RIG UP _____

SAND _____

DRILLING AND REMARKS: _____

GAS _____

OIL _____

TOTAL DEPTH 2705

PRODUCTION

1ST 24 HRS. NAT. _____

1ST 24 HRS. AFTER SHOT _____

GAS _____ CU. FT.

DRY HOLE ☒

ABANDONED ☒

DATE

4/25 1923

SCOUT