


Map No. **KANSAS** Sec. **27** Twp. **22** R. **12E**

Well No. **1-Mooney** Farm

Rhoades & Empire Company

NORTH

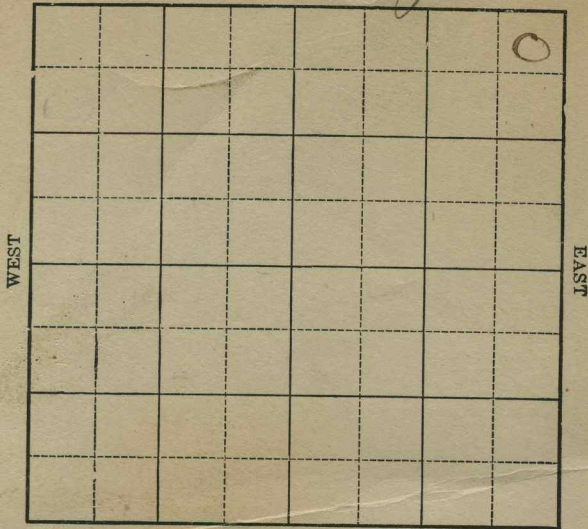

SOUTH

Location
Drilling Remarks

Rig Up
Drilling Remarks

RECORD

Cased _____ in. _____ ft.
 Sand _____
 Gas _____
 Oil _____
 Total Depth _____

PRODUCTION

1st 24 hrs. Nat. _____
 1st 24 hrs. after shot _____
 Gas _____ cu. ft.
 Dry Hole _____
 Abandoned _____

Map No. **KANSAS** Sec. **27** Twp. **22** R. **12**

Well No. **1-Mooney** Farm

Rhoades & Empire Company


NORTH

330 Ft. from N. Line

_____ Ft. from S. Line

330 Ft. from E. Line

_____ Ft. from W. Line

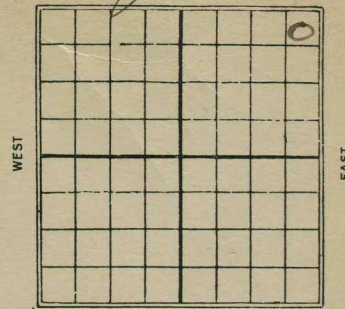

SOUTH

1927

Date REPORT

12/17 Rig up mch.
 12/14 Spudding
 12/21 Drlg 365-
 12/29 " 780
 1/5 Drlg 1240-
 1/11 Sdy shale 1684-1725
 sand 1725-40-H.F.W.
 Top line 1775 - Drlg 1785
 1/18 Sandy shale 1684-1725
 sand 1725-40 H.F.W.
 Top line 1775
 H.F.W. 1880-1913
 Abandoned 1913

Sherwood

Map No. **21 KANSAS** Sec. *27* Twp. *22* R. *12*

Well No. *1 Mooney*

Rhodes & Empire Company

Contractor

COMPLETED

SECTION PLAT

330 Ft. from N. Line

Ft. from S. Line

330 Ft. from E. Line

Ft. from W. Line

			0

ABANDONED

Location

Rig up

Drilling and Remarks:

dry shale 1684-1725

sand 1725-40 AFW

top line 1775

AFW 1860-1913

RECORD

Cased in., ft.

Sand

Gas

Oil

Total Depth *1913*

PRODUCTION

1st 24 hrs. Nat.

1st 24 hrs. after shot

Gas Cu. Ft.

Dry Hole

Abandoned

Date

JAN 13 1928

CHAS. L. SHERWOOD

192

Scout

Sherwood

Map No. **21 KANSAS** Sec. *27* Twp. *22* R. *12*

Well No. *1 Mooney*

Rhodes & Empire Company

Contractor

FIRST REPORTS

SECTION PLAT

330 Ft. from N. Line

Ft. from S. Line

330 Ft. from E. Line

Ft. from W. Line

			0

Location

Rig up

Drilling and Remarks:

Rigs up the king

RECORD

Cased in., ft.

Sand

Gas

Oil

Total Depth

PRODUCTION

1st 24 hrs. Nat.

1st 24 hrs. after shot

Gas Cu. Ft.

Dry Hole

Abandoned

Date

DEC 7 1927

CHAS. L. SHERWOOD

192

Scout