


Map No. _____ Sec. 27 Twp. 22 R. 11

Well No. 8 Wick Farm _____

Skelly Company _____

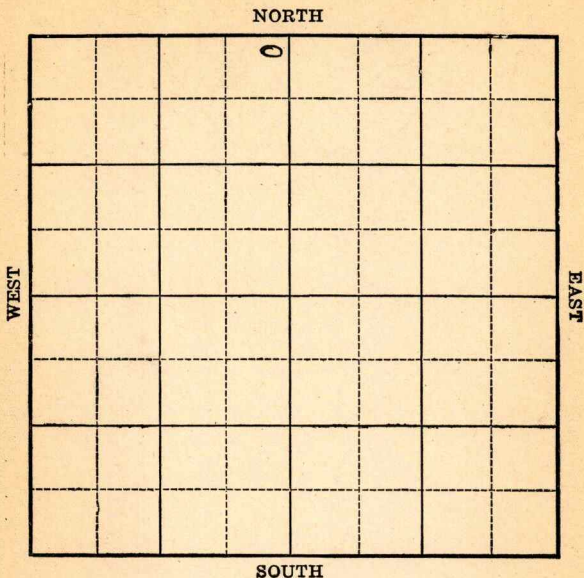

Location _____

Drilling Remarks:

Rig up _____

Drilling Remarks:

RECORD

Cased _____ in. _____ ft.

Sand _____

Gas _____

Oil _____

Total Depth _____

PRODUCTION

1st 24 hrs Nat. _____

1st 24 hrs. after shot _____

Gas _____ cu. ft.

Dry Hole _____

Abandoned _____

Map No. **KANSAS** 21 Sec. 27 Twp. 22 R. 11

Well No. *J. Wisk*

Skelly Oil Company

Contractor

COMPLETED SECTION PLAT

330 Ft. from N. Line

_____ Ft. from S. Line

330 Ft. from E. Line

_____ Ft. from W. Line

	0		

Location _____

Rig up _____

Drilling and Remarks:

sand 51941
1962 T.D.
shot 40/50 T.D.

RECORD

Cased _____ in., _____ ft.

Sand _____

Gas _____

Oil _____

Total Depth _____

PRODUCTION

1st 24 hrs. Nat. _____

1st 24 hrs. after shot _____

Gas _____ Cu. Ft.

Dry Hole _____

Abandoned _____

Date

JUN 10 1923
192

M. A. BENEAR

Scout

Map No. **KANSAS** ²¹ Sec. **27** Twp. **22** R. **11**

Well No. **8 Wick**

S Kelly Company
Contractor

FIRST REPORT

SECTION PLAT

330 Ft. from N. Line

Ft. from S. Line

330 Ft. from E. Line

Ft. from W. Line

	0		

Location **✓ ✓**

Rig up

Drilling and Remarks:

RECORD

Cased _____ in., _____ ft.
Sand _____
Gas _____
Oil _____
Total Depth _____

PRODUCTION

1st 24 hrs. Nat. _____
1st 24 hrs. after shot _____
Gas _____ Cu. Ft.
Dry Hole _____
Abandoned _____

Date **APR 7 1923**
192

M. A. BENEAR

Scout